

STATE ENGINEER
Salem, Oregon

M 1 21..... Well Record

11490

STATE WELL NO. 8/3W-7J(1)
COUNTY Marion
APPLICATION NO. GR- 520

OWNER: Alex W. AgalzOff


MAILING ADDRESS: Rt. 2 Box 57

LOCATION OF WELL: Owner's No.

CITY AND STATE: Salem, Oregon

NE 1/4 SE 1/4 Sec. 7 T. 8 S., R. 3 W., W.M.

Bearing and distance from section or subdivision corner 900' S. & 650' W. from E 1/4 cor. sec. 7

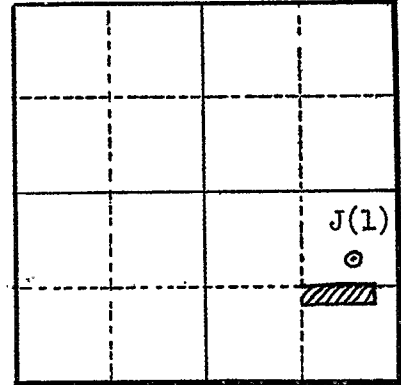

Section 7

Altitude at well 665

TYPE OF WELL: Drilled Date Constructed 1-7-55

Depth drilled 289' Depth cased 32 1/2'

CASING RECORD:

6 inch

FINISH:

AQUIFERS:

WATER LEVEL:

164 feet (1-7-55)

PUMPING EQUIPMENT: Type Berkeley, Subm. H.P. 3

Capacity 32 G.P.M.

WELL TESTS:

Drawdown 21.6 ft. after 1/2 hours 55 G.P.M.
Drawdown 24.6 ft. after 50 min. 68 G.P.M.

USE OF WATER Irrigation (3 acres) Temp. °F., 19

SOURCE OF INFORMATION GR- 498

DRILLER or DIGGER Harry Robinson

ADDITIONAL DATA:

Log Water Level Measurements Chemical Analysis Aquifer Test

REMARKS:

Top soil 0 to 9
Broken rock 9 to 289