ORIGINAL
File Original and Duplicate with the STATE ENGINEER, SALEM, OREGON

WATER WELL REPORT
STATE OF OREGON

State Well No. 8/3W-7J (1)

State Permit No.

(1) OWNER:
Name Glenn Agalzoff
Address Rt 3 Box 5 Pal Salem Ore

(2) LOCATION OF WELL:
Owner's number, if any— #1

County Marion (Marion) T. 8S R. 3W W.M.

NE ¼ SE ¼ Section 7

Bearing and distance from section or subdivision corner

900 feet South 650 West from E¼ Cor. Sect. 7.

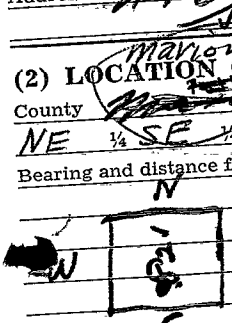

821 Ft FROM NORTH LINE
458 FROM CENTER OF ROAD.

(3) TYPE OF WORK (check):
New Well ☐ Deepening ☐ Reconditioning ☒ Abandon ☐

If abandonment, describe material and procedure in Item 11.

(4) PROPOSED USE (check):
Domestic ☒ Industrial ☐ Municipal ☐
Irrigation ☒ Test Well ☐ Other ☐

(5) TYPE OF WELL:
Rotary ☐ Driven ☐
Cable ☒ Jetted ☐
Dug ☐ Bored ☐

(6) CASING INSTALLED:
Threaded ☐ Welded ☒

6 5/8" Diam. from ½ ft. to 225 ft. Gage .280

" Diam. from ft. to ft. Gage

" Diam. from ft. to ft. Gage

(7) PERFORATIONS:
Perforated? ☐ Yes ☒ No

Type of perforator used

SIZE of perforations in. by in.

perforations from ft. to ft.

perforations from ft. to ft.

perforations from ft. to ft.

perforations from ft. to ft.

perforations from ft. to ft.

(8) SCREENS:
Well screen installed ☐ Yes ☒ No

Manufacturer's Name Model No.

Diam. Slot size Set from ft. to ft.

Diam. Slot size Set from ft. to ft.

(9) CONSTRUCTION:
Was well gravel packed? ☐ Yes ☒ No Size of gravel:

Gravel placed from ft. to ft.

Was a surface seal provided? ☐ Yes ☐ No To what depth? 22½ ft.

Material used in seal—

Did any strata contain unusable water? ☒ Yes ☐ No

Type of water? surface Depth of strata 10 ft.

Method of sealing strata off Refer to log

(10) WATER LEVELS:
Static level 164 ft. below land surface Date 7-16-55

Artesian pressure none lbs. per square inch Date

Log Accepted by:

[Signed] (Owner) Date 5-18-, 1957

(11) WELL TESTS:
Drawdown is amount water level is lowered below static level

Was a pump test made? ☒ Yes ☐ No If yes, by whom? Stettler

Yield: gal./min. with ft. drawdown after hrs.

" " " "

" " " "

Bailer test gal./min. with ft. drawdown after hrs.

Artesian flow g.p.m. Date

Temperature of water Was a chemical analysis made? ☐ Yes ☐ No

(12) WELL LOG:
Diameter of well 6 inches.

Depth drilled ft. Depth of completed well 289 ft.

Formation: Describe by color, character, size of material and structure, and show thickness of aquifers and the kind and nature of the material in each stratum penetrated, with at least one entry for each change of formation.

MATERIAL	FROM	TO
Reamed hole to 10"	0.	30
cleaned out well to 289		
Found shale mixed with		
Rock cuttings at 289 ft		
well reported to be 305 ft deep originally		

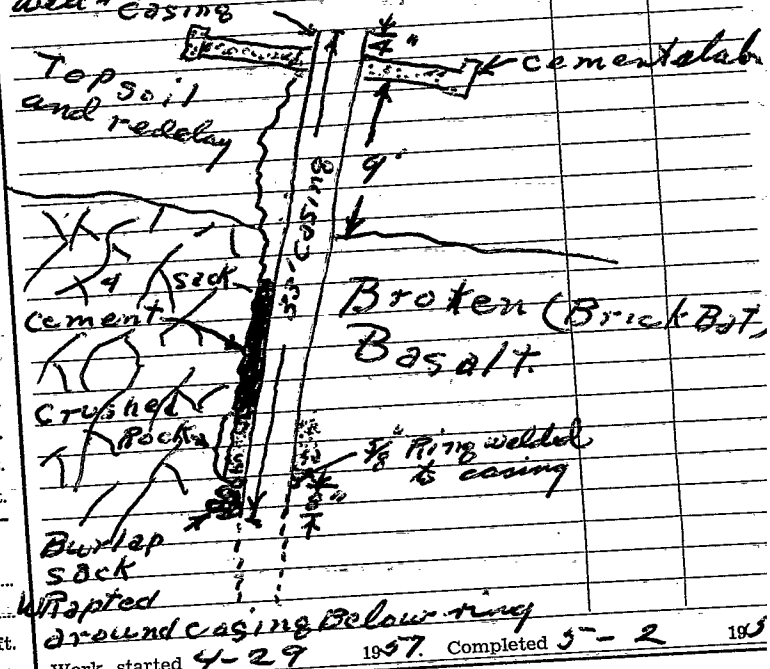

Work started 4-29 1957. Completed 5-2 1957

(13) PUMP:
Manufacturer's Name H.P.

Type:

Well Driller's Statement:

This well was drilled under my jurisdiction and this report is true to the best of my knowledge and belief.

NAME H A Robinson (Person, firm, or corporation) (Type or print)

Address 2214 N Front St Salem Ore

Driller's well number 8/3W-7J 1

[Signed] Harry A Robinson (Well Driller)

License No. 22 Date May 3, 1957