

Walt Wilmes Farms, Inc.

Material	From	To
Top soil	0	13
Clay, brown	13	70
Clay, dark brown soft w/ rusty coarse sand & pea gravel	70	77
Sand, brown medium & fine pea gravel	77	80
Sand, black medium	80	99
Rock, round 3/4" up to 4"-5"	99	104
Sand, black medium	104	117
Clay, blue fine sandy	117	123
Clay, blue	123	126
Sand, black medium	126	136
Clay, blue gray	136	143
Clay, gray	143	166
Gravel, coarse to 2"	166	193
Clay, gray	193	200
Clay, green sandy	200	204
Clay, gray	204	213

Casing Installed:

12" Diameter from +2'6" to 133'10"	Gage .330
12" Diameter from 133'10" to 195'5"	Gage .375
12" Diameter from 195'5" to 215'9"	Gage .250
6" Diameter from 0 to 63'	Gage .250 (Gravel feed)

200
100
0
Pumping Level

Started 9:00 A.M.

0
200
400
600
800
1000
1200
1400
1600
1800
gpm

4:41 - 88'
4:30 - 93' } Recovery

Shut off 4:28 PM


590 gpm 116' - 4:28 PM

880 gpm 138' 4:01 PM

1360 gpm 153' at 3:33 PM

1640 gpm - 174' at 2:50 PM

Running since 2:50 PM

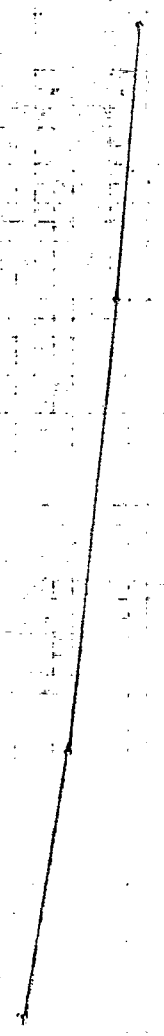

12" well -
Wells Wilford
Setting well test

1-18-77