

STATE ENGINEER
Salem, Oregon


1131
11649

Well Record

STATE WELL NO. 8/3W-9F1
COUNTY Marion
APPLICATION NO. CR-3626

OWNER: Victor E. Gibson
MAILING ADDRESS: 240 Cunningham Lane
CITY AND STATE: Salem, Oregon

LOCATION OF WELL: Owner's No. _____
SE 1/4 NW 1/4 Sec. 9 T. 8 S., R. 3 W., W.M.
Bearing and distance from section or subdivision
corner 216' S. & 143' W. from NE cor. Lot 34

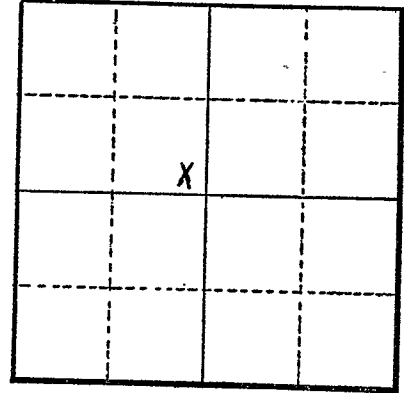

Section 9

Altitude at well _____

TYPE OF WELL: Drilled Date Constructed Nov. 27, 1950
Depth drilled 210 feet Depth cased 200 feet

CASING RECORD:

8 inch casing set to 200 feet

FINISH:

AQUIFERS:

WATER LEVEL:

60 feet below surface

PUMPING EQUIPMENT: Type Universal Deep well jet H.P. 3
Capacity 50 G.P.M.

WELL TESTS:

Drawdown _____ ft. after _____ hours _____ G.P.M.
Drawdown _____ ft. after _____ hours _____ G.P.M.

USE OF WATER Irrigation Temp. _____ °F. _____, 19____

SOURCE OF INFORMATION Well Registration Statement

DRILLER or DIGGER Studebaker Brothers

ADDITIONAL DATA:

Log Water Level Measurements _____ Chemical Analysis _____ Aquifer Test _____

REMARKS:

Log: Sixty feet through dirt, clay and clay rock small amount of water at this depth. Rest of depth through rock.