

STATE ENGINEER
Salem, Oregon

M 1 31. Well Record

STATE WELL NO. 8/3W-9K(2)
COUNTY Marion
APPLICATION NO. GR- 732

OWNER: United Growers Inc.


MAILING ADDRESS: P.O. Box 586

LOCATION OF WELL: Owner's No. 1

CITY AND STATE: Salem, Oregon

NW 1/4 SE 1/4 Sec. 9 T. 8 N. S. R. 3 W., W.M.

Bearing and distance from section or subdivision corner 1613.76' N.15°E., 204.25' S.85°06'E., and 313.56' N.8°50'E. from SW cor. of J. R. Patterson DLC.

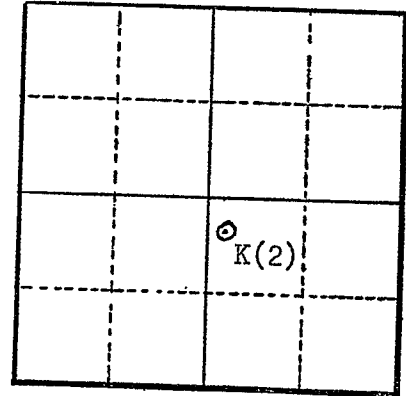

Altitude at well 450

TYPE OF WELL: Drilled Date Constructed 1933

Depth drilled 67' Depth cased 50'

Section 9

CASING RECORD:

6 inch from 0 to 50 feet

FINISH:

Don't accept AG for use.

AQUIFERS:

use IM

per - Anna

WATER LEVEL:

20 feet

PUMPING EQUIPMENT: Type None

Capacity G.P.M.

H.P.

WELL TESTS:

Drawdown 23 ft. after hours 40 G.P.M.

Drawdown ft. after hours G.P.M.

USE OF WATER Food processing

SOURCE OF INFORMATION GR- 708 Temp. °F. 19

DRILLER or DIGGER

ADDITIONAL DATA:

Log None Water Level Measurements Chemical Analysis Aquifer Test

REMARKS: