

STATE ENGINEER
Salem, Oregon

Marion

Well Record
11654

STATE WELL NO. 8/3W-9K(3)
COUNTY Marion
APPLICATION NO. GR- 733

OWNER: United Growers Inc.


MAILING ADDRESS: P. O. Box 586

LOCATION OF WELL: Owner's No. 2

CITY AND STATE: Salem, Oregon

NW 1/4 SE 1/4 Sec. 9 T. 8 S., R. 3 W., W.M.

Bearing and distance from section or subdivision corner 1013.76' N.15°E., 204.25' S.85°06'E., 388.06' N.8°50'E., and 197' S.74°17'E. from SW cor. of the J.R. Patterson DIC.

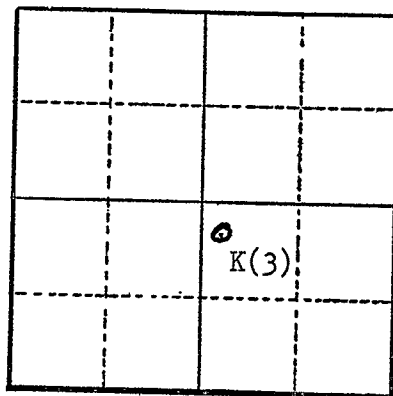

Section 9

Altitude at well

TYPE OF WELL: Drilled Date Constructed 1941

Depth drilled 87' Depth cased 65'

CASING RECORD:

8 inch from 0 to 65 feet

FINISH:

AQUIFERS:

WATER LEVEL:

17 feet

PUMPING EQUIPMENT: Type U. S. Motors, turbine H.P. 3
Capacity 60 G.P.M.

WELL TESTS:

Drawdown 35 ft. after hours 60 G.P.M.

Drawdown ft. after hours G.P.M.

USE OF WATER Food processing Temp. °F. 19

SOURCE OF INFORMATION GR- 709

DRILLER or DIGGER West Well Drilling, Salem

ADDITIONAL DATA:

Log None Water Level Measurements Chemical Analysis Aquifer Test

REMARKS: