

STATE ENGINEER  
Salem, Oregon

M 131  
11655

# Well Record

STATE WELL NO. 8/3W-9K(4)  
COUNTY Marion  
APPLICATION NO. GR- 734

OWNER: United Growers Inc.

MAILING ADDRESS: P.O. Box 586

LOCATION OF WELL: Owner's No. 3

CITY AND STATE: Salem, Oregon


NW 1/4 SE 1/4 Sec. 9 T. 8 N. S., R. 3 W., W.M.

Bearing and distance from section or subdivision

corner 1013.76' N.15°E., 204.25' S.85°06'E.,

592.56' N.8°50'E., and 276' S.74°17'E. from

the J.R. Patterson DLC.

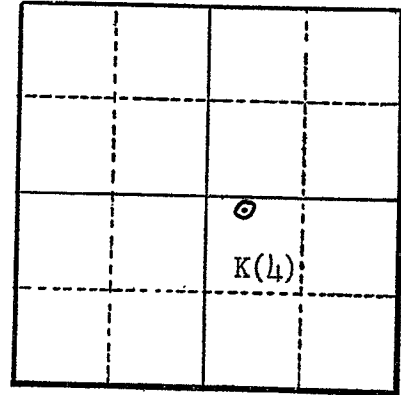

Section 9

Altitude at well

TYPE OF WELL: Drilled Date Constructed 1943

Depth drilled 99' Depth cased 60'

### CASING RECORD:

8 inch from 0 to 60 feet

### FINISH:

### AQUIFERS:

### WATER LEVEL:

30 feet

PUMPING EQUIPMENT: Type U. S. Motors, Jacuzzi jet H.P. 10  
Capacity 40 G.P.M.

### WELL TESTS:

Drawdown 50 ft. after hours 40 G.P.M.

Drawdown ft. after hours G.P.M.

USE OF WATER Food processing Temp. °F. 19

SOURCE OF INFORMATION GR- 710

DRILLER or DIGGER

### ADDITIONAL DATA:

Log None Water Level Measurements Chemical Analysis Aquifer Test

### REMARKS: