

STATE ENGINEER
Salem, Oregon

M 1 21 Well Record

11656

STATE WELL NO. 8/3W-9K(5)
COUNTY Marion
APPLICATION NO. GR- 735

OWNER: United Growers Inc.


MAILING ADDRESS: Box 586

LOCATION OF WELL: Owner's No. 4

CITY AND STATE: Salem, Oregon

NW 1/4 SE 1/4 Sec. 9 T. 8 S., R. 3 W., W.M.

Bearing and distance from section or subdivision corner 1013.76' N.15°E., 204.25' S.85°06'E., 588.06' N.8°50'E., 448' S.74°17'E. from the SW cor. of the J. R. Patterson DLC.

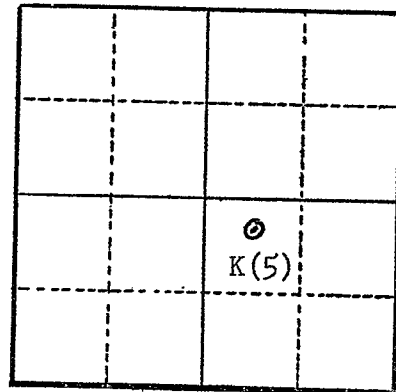

Section 9

Altitude at well

TYPE OF WELL: Drilled Date Constructed 1945

Depth drilled 120' Depth cased 80'

CASING RECORD:

6 inch from 0 to 80 feet

FINISH:

AQUIFERS:

WATER LEVEL:

30 feet

PUMPING EQUIPMENT: Type U.S. Motors, turbine

H.P. 5

Capacity 60 G.P.M.

WELL TESTS:

Drawdown 45 ft. after 60 hours G.P.M.

Drawdown ft. after hours G.P.M.

USE OF WATER Food processing

Temp. °F. 19

SOURCE OF INFORMATION GR- 711

DRILLER or DIGGER West Well Drilling, Salem

ADDITIONAL DATA:

Log None Water Level Measurements Chemical Analysis Aquifer Test

REMARKS: