

STATE ENGINEER  
Salem, Oregon

M 1 31

11657

# Well Record

STATE WELL NO. 8/3W-9K(6)  
COUNTY Marion  
APPLICATION NO. GR- 736

OWNER: United Growers Inc.


MAILING ADDRESS: Box 586

LOCATION OF WELL: Owner's No. 5

CITY AND STATE: Salem, Oregon

NW 1/4 SE 1/4 Sec. 9 T. 8 N. S. R. 3 W., W.M.

Bearing and distance from section or subdivision corner 1013.76' N.15°E., 204.25' S.85°06'E., 121' N.8°50'E., and 197' S.74°17'E. from the SW cor. of the J.R. Patterson DLC.

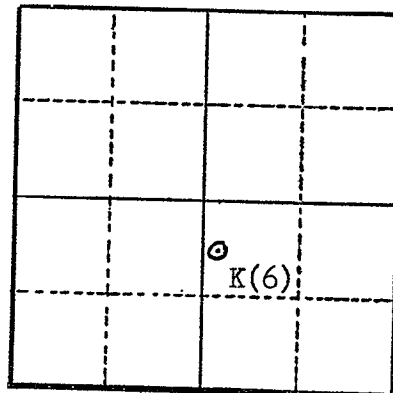

Section 9

Altitude at well

TYPE OF WELL: Drilled Date Constructed 1945

Depth drilled 120' Depth cased 70'

### CASING RECORD:

8 inch from 0 to 70 feet

### FINISH:

### AQUIFERS:

### WATER LEVEL:

30 feet

PUMPING EQUIPMENT: Type U.S. Motors, jacuzzi jet

Capacity 60 G.P.M. H.P. 3

### WELL TESTS:

Drawdown 50 ft. after hours 60 G.P.M.

Drawdown ft. after hours G.P.M.

USE OF WATER Food processing Temp. °F. 19

SOURCE OF INFORMATION GR- 712

DRILLER or DIGGER West Well Drilling, Salem

### ADDITIONAL DATA:

Log None Water Level Measurements Chemical Analysis Aquifer Test

### REMARKS: