

STATE ENGINEER  
Salem, Oregon

M 1 21.....  
11663

# Well Record

STATE WELL NO. 8/3W-9R<sub>2</sub>  
COUNTY MARION  
APPLICATION NO. GR-1967


OWNER: Joseph C. Renault & Irene T. Renault MAILING ADDRESS: 350 Boone Rd.

LOCATION OF WELL: Owner's No. \_\_\_\_\_ CITY AND STATE: Salem, Oregon

SE  $\frac{1}{4}$  SE  $\frac{1}{4}$  Sec. 9 T. 8 S., R. 3 W., W.M.

Bearing and distance from section or subdivision

corner 200' W. 100' N.

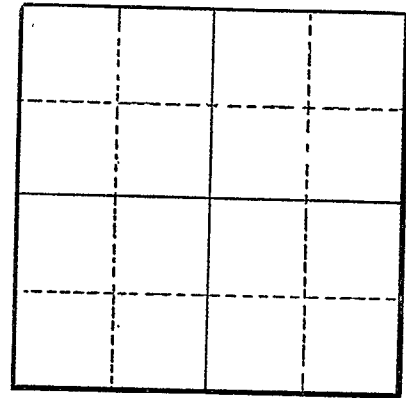

Section \_\_\_\_\_

Altitude at well \_\_\_\_\_

TYPE OF WELL: Drilled Date Constructed 1952

Depth drilled 116' Depth cased 70'

### CASING RECORD:

6-inch

### FINISH:

None

### AQUIFERS:

Solid rock

### WATER LEVEL:

50-feet

PUMPING EQUIPMENT: Type Universal Jet H.P. 2

Capacity 1450 G.P.M./hour

### WELL TESTS:

Drawdown 5 ft. after \_\_\_\_\_ hours Pumping 35 G.P.M.

Drawdown \_\_\_\_\_ ft. after \_\_\_\_\_ hours \_\_\_\_\_ G.P.M.

USE OF WATER Irrigation Temp. \_\_\_\_\_ °F., 19 \_\_\_\_\_

SOURCE OF INFORMATION GR-1895

DRILLER or DIGGER Harlan Miller 5220 Sunnyview Ave., Salem, Oregon

### ADDITIONAL DATA:

Log \_\_\_\_\_ Water Level Measurements \_\_\_\_\_ Chemical Analysis \_\_\_\_\_ Aquifer Test \_\_\_\_\_

### REMARKS:

Log of well was not maintained  
70' of 6" casing put well into solid Rock