

STATE ENGINEER
Salem, Oregon

Well Record

STATE WELL NO. 8/3W-9R(1)
COUNTY Marion
APPLICATION NO. GR- 14

OWNER: Salem Heights Water District

MAILING ADDRESS: 3725 S. Commercial St.

LOCATION OF WELL: Owner's No. Doege #5

CITY AND STATE: Salem, Oregon

SE $\frac{1}{4}$ SE $\frac{1}{4}$ Sec. 9 T. 8 N. 3 W., W.M.


Bearing and distance from section or subdivision

corner

Altitude at well 440.37

TYPE OF WELL: Drilled Date Constructed Apr. 1953

Depth drilled 137' Depth cased 100'

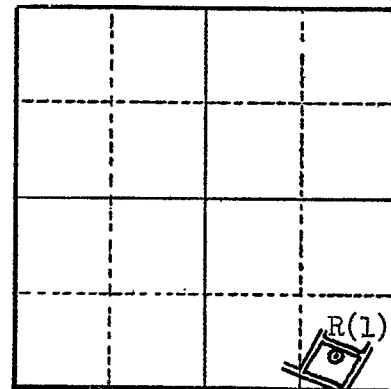

Section 9

CASING RECORD:

8 inch from 0 to 100 feet (#25 casing)

FINISH:

Perforations from 83 to 86 feet and from 90 to 96 feet

AQUIFERS:

Basalt, from 90 to 96 feet

WATER LEVEL:

12 feet below land surface

PUMPING EQUIPMENT: Type Berkeley, turbine
Capacity 225 G.P.M.

H.P. 25

WELL TESTS:

Drawdown ft. after hours G.P.M.

Drawdown ft. after hours G.P.M.

USE OF WATER Municipal

Temp. °F., 19.....

SOURCE OF INFORMATION GR- 12

DRILLER or DIGGER Duffield Bros., Salem

ADDITIONAL DATA:

Log X Water Level Measurements Chemical Analysis Aquifer Test

REMARKS:

Well abandoned in 1965

STATE ENGINEER
Salem, Oregon

State Well No. 8/31-9 R(1)
County MARION
Application No. GR-14

Well Log

Owner: SALEM HEIGHTS WATER DISTRICT Owner's No. Doege Well

Driller: _____ Date Drilled April, 1953

[illegible]