

STATE ENGINEER
Salem, Oregon

M 131
Ticket

Well Record

STATE WELL NO. 8/3W-90
COUNTY Marion
APPLICATION NO. GR-3879

OWNER: Mervin Seeger


MAILING ADDRESS: 180 Boone Rd. S.E.

LOCATION OF WELL: Owner's No.

CITY AND STATE: Salem, Oregon

SW 1/4 SE 1/4 Sec. 9 T. 8 S., R. 3 W., W.M.

Bearing and distance from section or subdivision corner about 610' N. & 1720' W. from SE Cor. Sec. 9

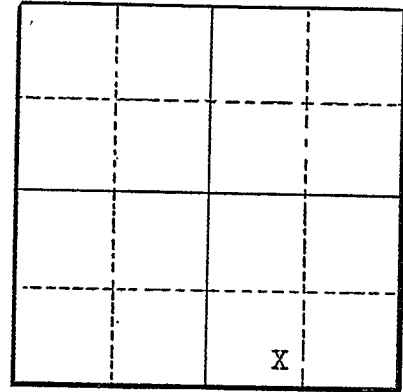

Section 9

Altitude at well 455 ft

TYPE OF WELL: Drilled Date Constructed 1950

Depth drilled 46 feet Depth cased 46 feet

CASING RECORD:

6 inch casing set to 46 feet

FINISH:

AQUIFERS:

weathered basalt

WATER LEVEL:

16 feet below surface

PUMPING EQUIPMENT: Type Universal jet

Capacity 15 G.P.M. H.P. 1

WELL TESTS:

Drawdown ft. after hours G.P.M.

Drawdown ft. after hours G.P.M.

USE OF WATER Irrigation Temp. °F., 19

SOURCE OF INFORMATION Well Registration Statement Cert. # GR-3528

DRILLER or DIGGER Don Duffield

ADDITIONAL DATA:

Log Water Level Measurements Chemical Analysis Aquifer Test

REMARKS: