

STATE ENGINEER
Salem, Oregon

M 1 3 1 Well Record
11685

STATE WELL NO. 8/3W-10C(1)
COUNTY Marion
APPLICATION NO. GR- 14

OWNER: Salem Heights Water District

MAILING

ADDRESS: 3725 S. Commercial St.

LOCATION OF WELL: Owner's No. Gardner #1


CITY AND

STATE: Salem, Oregon

NE 1/4 NW 1/4 Sec. 10 T. 8 N. S. R. 3 W., W.M.

Bearing and distance from section or subdivision

corner 125' E. and 132' N. from the SE cor. of
Lot 99 of the Ewald Fruit Farms.

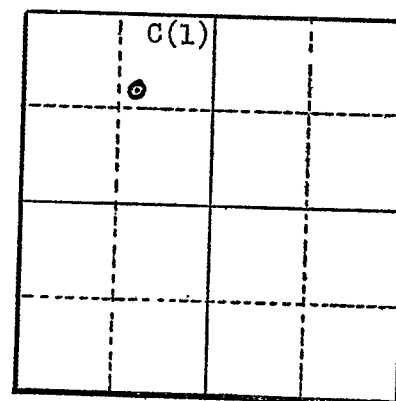

Section 10

Altitude at well 408.09

TYPE OF WELL: Drilled Date Constructed Mar. 1952

Depth drilled 319' Depth cased 78'

CASING RECORD:

8 inch from 0 to 78 feet (#25 casing)

FINISH:

None

AQUIFERS:

Basalt, 76 to 319 feet

WATER LEVEL:

92 feet below land surface (Mar. 1952)

PUMPING EQUIPMENT: Type Berkeley

Capacity 100 G.P.M.

H.P. 15 & 10 B'st

WELL TESTS:

Drawdown ft. after hours G.P.M.

Drawdown ft. after hours G.P.M.

USE OF WATER Municipal

Temp. °F., 19.....

SOURCE OF INFORMATION GR- 12

DRILLER or DIGGER Duffield Bros., Salem

ADDITIONAL DATA:

Log ^X Water Level Measurements Chemical Analysis Aquifer Test

REMARKS:

Has 300 feet of airline

STATE ENGINEER
Salem, Oregon

State Well No. 8/3W-10C(1)

County Marion

Application No. GR-14

Well Log

Owner: Salem Heights Water District Owner's No. Gardner well

Driller: _____ Date Drilled _____

[illegible]

STATE ENGINEER
Salem, Oregon

State Well No. 8/3W-10C(1)

County Marion

Application No. _____

Water Level Record

OWNER: Salem Heights Water Dist. OWNER'S NO. #1 (Gardner)

Description of measuring point: Owners Air line gage 0.2 foot above L.S.D.

319 feet deep (Air line 300 feet)

958
Elev. 307.57

Date	Water Level Feet (above) (below) Land Surface	Remarks	Date	Water Level Feet (above) (below) Land Surface	Remarks
3-4-58	246.67	23 [#]			
4-1-58	244.36	24 [#]			
6-4-58	246.67	23 [#]			
9-1-58	262.84	16 [#]			
9-23-58	258.22	18 [#]			
12-1-58	255.91	19 [#]			
3-7-59	265.15	15 [#]			
4-1-59	246.67	23 [#]			
10-31-59	272.08	12 [#]			
11-4-59	272.08	12 [#]			
12-30-59	272.08	12 [#]			
2-2-60	267.26	14 [#]			
4-29-60	265.15	15 [#]			
5-1-60	265.15	15 [#]			
7-7-61	288.25	5 [#]			

REMARKS: _____

REPORT OF MINERAL ANALYSIS OF WATER

RESULTS

Remarks _____