

STATE ENGINEER
Salem, Oregon

M 1 21 ... Well Record
11688

STATE WELL NO. 8/3W-10P,
COUNTY MARION
APPLICATION NO. GR-2813

OWNER: Joseph P. and Helen E. Prinz


MAILING ADDRESS: 655 Boone Road

LOCATION OF WELL: Owner's No.

CITY AND STATE: Salem, Oregon

SE 1/4 SW 1/4 Sec. 10 T. 8 N. S. R. 3 W., W.M.

Bearing and distance from section or subdivision corner 1970' E. and 280' N.

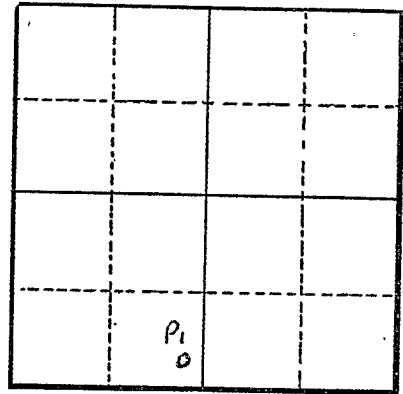

Altitude at well

TYPE OF WELL: drilled Date Constructed 1952

Depth drilled 156 Depth cased

Section 10

CASING RECORD:

FINISH:

AQUIFERS:

WATER LEVEL:

PUMPING EQUIPMENT: Type Jacuzzi submersible H.P. 3
Capacity 90 G.P.M.

WELL TESTS:

Drawdown ft. after hours G.P.M.

Drawdown ft. after hours G.P.M.

USE OF WATER irrigation Temp. °F. 19

SOURCE OF INFORMATION GR-2654

DRILLER or DIGGER Saunders

ADDITIONAL DATA:

Log Water Level Measurements Chemical Analysis Aquifer Test

REMARKS: