

STATE ENGINEER
Salem, Oregon

MAR 11 1952
OBSERVATION WELL
Well Record

STATE WELL NO. 4/2W-15F(1)
COUNTY Marion
APPLICATION NO. GR-190


W. O. WILDMAR

OWNER: Melvin R. DuRette MAILING ADDRESS: _____

LOCATION OF WELL: Owner's No. _____ #1 CITY AND STATE: St. Paul, Oregon

SE 1/4 NW 1/4 Sec. 15 T. 4 S., R. 2 W., W.M.

Bearing and distance from section or subdivision
corner N 55° W, 1306.8' & S 42° 35' W, 1393.0'
then N 47° 25' W, 75' from the most
southerly SE cor. of the Peter Papin
DLC #85 OR 595' N. & 600' W. from center of
Sec. 15

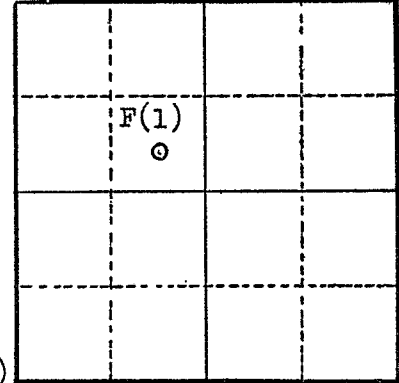

Altitude at well _____

TYPE OF WELL: Drilled Date Constructed 4/21/53 (before)

Depth drilled 110 Depth cased 110

Section 15

CASING RECORD:

18 inch casing set from 0 to 110 feet

FINISH:

open end casing

AQUIFERS:

sands and gravel 79 to 88 feet 103 to 110 feet

WATER LEVEL:

34 feet below land surface April 21, 1953. 34.38 November 30, 1959

PUMPING EQUIPMENT: Type Deep well turbine H.P. 30
Capacity 425 G.P.M.

WELL TESTS:

Drawdown 65 ft. after _____ hours pumping 600 4/21/53 G.P.M.
Drawdown 58 ft. after _____ hours pumping 500 G.P.M.

USE OF WATER Irrigation 147.1 acres Temp. _____ °F., 19

SOURCE OF INFORMATION Registration Statement GR-190

DRILLER or DIGGER _____

ADDITIONAL DATA:

Log Yes Water Level Measurements _____ Chemical Analysis _____ Aquifer Test _____

REMARKS:

STATE ENGINEER
Salem, Oregon

State Well No. 4/2w-1350

County Marion

Application No. GR-190
GR-176

Water Level Record

OWNER: Melvin Durette OWNER'S NO. #1

Description of measuring point: Top of open casing set in concrete
MP on south side of well - is 0.5 feet above LSD.
+0.50

| Date | Water Level Feet (above) (below) Land Surface | Remarks | Date | Water Level Feet (above) (below) Land Surface | Remarks |
|----------|---|----------|------|---|---------|
| 6-5-57 | 28.39 | WSB | | | |
| 10-15-57 | 36.58 | WSB | | | |
| 6-11-58 | 30.52 | WSB | | | |
| 12-16-58 | 33.22 | WSB | | | |
| 5-6-59 | 27.58 | WSB | | | |
| 11-30-59 | 34.88 | WSB | | | |
| 6-6-60 | 27.39 | WSB | | | |
| 11-7-60 | 34.79 | WSB | | | |
| 11-2-61 | 33.99 | WSB & RD | | | |
| | | | | | |
| | | | | | |
REMARKS: _____

