

STATE ENGINEER  
Salem, Oregon

# Well Record

STATE WELL NO. 4/2W - 15M1  
COUNTY MARION  
APPLICATION NO. GR-2002

MARI. 1183

OWNER: A. R. & Vista Buyserie


MAILING ADDRESS: Rt. 1, Box 370

LOCATION OF WELL: Owner's No. #1

CITY AND STATE: Woodburn, Oregon

NW SW 15 T. 4 S., R. 2 W., W.M.

Bearing and distance from section or subdivision corner 330' E. and 1780' N.

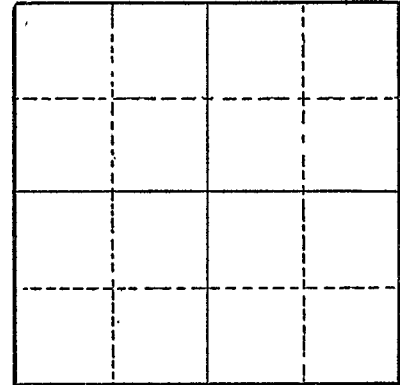

Section .....

Altitude at well .....

TYPE OF WELL: Drilled Date Constructed 1949

Depth drilled 127 Depth cased 127

CASING RECORD:

10-inch

FINISH:

AQUIFERS:

Clay

WATER LEVEL:

PUMPING EQUIPMENT: Type Peerless Turbine H.P. 25  
Capacity 500 G.P.M.

WELL TESTS:

Drawdown 75 ft. after ..... hours Pumping 575 G.P.M.  
Drawdown ..... ft. after ..... hours ..... G.P.M.

USE OF WATER Irrigation Temp. ..... °F. ...., 19.....

SOURCE OF INFORMATION GR-1932

DRILLER or DIGGER .....

ADDITIONAL DATA:

Log  Water Level Measurements ..... Chemical Analysis ..... Aquifer Test .....

REMARKS:

