

NOTICE TO WATER WELL CONTRACTOR

The original and first copy of this report are to be filed with the

RECEIVED WATER WELL REPORT OCT 21 1970 STATE OF OREGON STATE ENGINEER SALEM, OREGON

STATE ENGINEER, SALEM, OREGON 97310 within 30 days from the date of well completion.

(Please type or print)

Write above this line

MARI. 1.188 4/2W-16 State Well No. State Permit No.

(1) OWNER:

Name Ralph Schuetz Address 3721 NW 372 Hoodlum Ave 97071

(2) TYPE OF WORK (check):

New Well [x] Deepening [] Reconditioning [] Abandon []

If abandonment, describe material and procedure in Item 12.

(3) TYPE OF WELL:

Rotary [x] Driven [] Cable [] Jetted [] Dug [] Bored []

(4) PROPOSED USE (check):

Domestic [] Industrial [] Municipal [] Irrigation [x] Test Well [] Other []

CASING INSTALLED:

18" Diam. from +2- ft. to 2.15 1/2 ft. Gage 1250 * 10" Diam. from 0 ft. to 70 ft. Gage 1250 6" Diam. from +2- ft. to 116-9" ft. Gage 1250

PERFORATIONS:

Perforated? [x] Yes [] No. Type of perforator used torch Size of perforations 3/8 in. by 1/2 in. 1280 perforations from 125 1/2 ft. to 205 1/2 ft.

(7) SCREENS:

Well screen installed? [] Yes [x] No

Manufacturer's Name Type Model No. Diam. Slot size Set from ft. to Diam. Slot size Set from ft. to

(8) WATER LEVEL: Completed well.

Static level 27 ft. below land surface Date 6-8-70 Artesian pressure lbs. per square inch Date

(9) WELL TESTS:

Drawdown is amount water level is lowered below static level

Was a pump test made? [] Yes [] No If yes, by whom?

Yield: gal./min. with ft. drawdown after hrs. see attached sheet

Bailer test gal./min. with ft. drawdown after hrs.

Artesian flow g.p.m. Date

Temperature of water Was a chemical analysis made? [] Yes [] No

(10) CONSTRUCTION:

Well seal-Material used Cement Depth of seal 0 to 114' - 17 yds ft. Diameter of well bore to bottom of seal 3.6 in. Were any loose strata cemented off? [] Yes [x] No Depth Was a drive shoe used? [] Yes [x] No Did any strata contain unusable water? [] Yes [x] No Type of water? depth of strata Method of sealing strata off Was well gravel packed? [x] Yes [] No Size of gravel: 3/4-3/8 Gravel placed from 117 ft. to 215 ft.

(11) LOCATION OF WELL:

County Marion Driller's well number 7004 1/4 Section 16 T. 4S R. 2W W.M. Bearing and distance from section or subdivision corner

(12) WELL LOG:

Diameter of well below casing 0

Depth drilled 215 ft. Depth of completed well 205 ft.

Formation: Describe color, texture, grain size and structure of materials; and show thickness and nature of each stratum and aquifer penetrated, with at least one entry for each change of formation. Report each change in position of Static Water Level as drilling proceeds. Note drilling rates.

Table with columns: MATERIAL, From, To, SWL. Includes handwritten notes: * Perforated casing is 6" in gravel field 8" in " " # log see attached sheet. Set 75 hp turbine

Work started 10-28 1968 Completed 6-15 1970 Date well drilling machine moved off of well 6-15 1970

Drilling Machine Operator's Certification:

This well was constructed under my direct supervision. Materials used and information reported above are true to my best knowledge and belief.

[Signed] Edgar J. Muller Date, 1970 (Drilling Machine Operator)

Drilling Machine Operator's License No. 581

Water Well Contractor's Certification:

This well was drilled under my jurisdiction and this report is true to the best of my knowledge and belief.

NAME Milo Schneider Equipment Co (Person, firm or corporation) (Type or print)

Address Star Rt., Box 97 St. Paul, Ore

[Signed] (Water Well Contractor)

Contractor's License No. 387 Date 10-8, 1970

RECEIVED
OCT 21 1970

STATE ENGINEER
SALEM, OREGON

Ralph Schuetz
Rt. 1, Box 372
Woodburn, Ore. 97071

Driller's # 7004

Material	From	To
Top soil	0	2
Brown clay	2	34
blue clay	34	55
brown sand	55	57
brown clay	57	61
dark blue clay	61	63
brown sand	63	68
black sand	68	70
blue silt	70	79
black sand	79	81
blue clay	81	89
black sand	89	110
brown clay	110	117
black sand & wood	117	118
blue clay	118	119
black sand	119	120
blue silt & wood	120	136
black sand	136	145
blue clay	145	150
sand & gravel	150	158
blue clay sand layers	158	189
coarse sand & gravel 2"	189	190
soft brown clay	190	203
gravel	203	204
blue clay	204 215	215

33' - ~~Water~~ 7-22-69 9:00 AM ~~Water~~ Pump -
Investigation Well Test - 7-22-69
Ralph Edwards

RECEIVED
OCT 21 1970
STATE ENGINEER
SALEM, OREGON

7:15 70.18"
7:25 73.18"
7:35 75.21"
7:45 78.10"
7:55 81.09"
8:05 84.11"
8:15 87.16"


BY - MILD SCHNEIDER EQUIPMENT CO.
STAR ROUTE BOX 97
ST. PAUL, OREGON - PH 683-2666

695 GPM - 103' - 7:14 PM

940 GPM - 118' - 6:40 PM

1340 GPM - 130' - 6:06 PM

1560 GPM - 142' - 5:47 PM

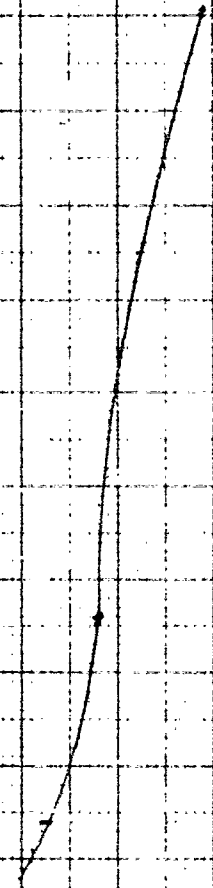

well # 7408

200
400
600
800
1000
1200
1400
1600
1800
GPM

50'
100'
150'
200'