

STATE ENGINEER
Salem, Oregon

MAR 11 1951

Well Record

STATE WELL NO. 4/2W - 16G 1
COUNTY MARION
APPLICATION NO. GR-2003

OWNER: A. R. & Vista Buyserie

MAILING ADDRESS: Rt. 1, Box 370


LOCATION OF WELL: Owner's No.

CITY AND STATE: Woodburn, Oregon

SW 1/4 NE 1/4 Sec. 16 T. 4 N. S. R. 2 W., W.M.

Bearing and distance from section or subdivision

corner 1460' W. and 400' N.

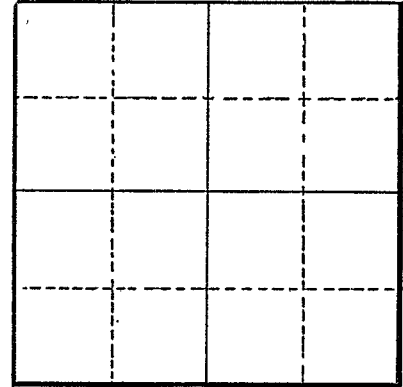

Section

Altitude at well

TYPE OF WELL: Drilled Date Constructed 1953

Depth drilled 196 Depth cased

CASING RECORD:

18-inch

FINISH:

AQUIFERS:

Clay

WATER LEVEL:

33-feet

PUMPING EQUIPMENT: Type Peerless turbine

H.P. 30

Capacity 500 G.P.M.

WELL TESTS:

Drawdown 83 ft. after hours Pumping 500 G.P.M.

Drawdown ft. after hours G.P.M.

USE OF WATER Irrigation Temp. °F., 19

SOURCE OF INFORMATION GR-1933

DRILLER or DIGGER

ADDITIONAL DATA:

Log Water Level Measurements Chemical Analysis Aquifer Test

REMARKS:

