

STATE ENGINEER
Salem, Oregon

MARI 11947
Well Record

STATE WELL NO. 8/W-15M(1)
COUNTY Marion
APPLICATION NO. GR- 544

OWNER: B.J. & Dorothy Dusenberg


MAILING ADDRESS: Rt. 4 Box 225

LOCATION OF WELL: Owner's No.

CITY AND STATE: Salem, Oregon

NW 1/4 SW 1/4 Sec. 15 T. 8 S., R. 3 W., W.M.

Bearing and distance from section or subdivision corner 2023' N. & 532' E. of the SW cor. sec. 15

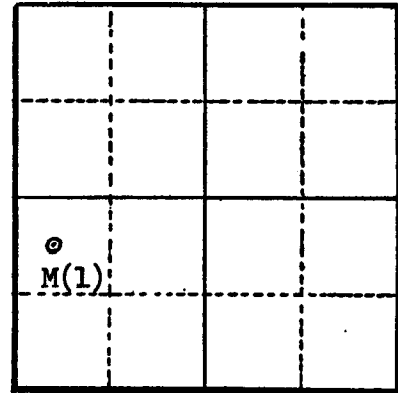

Altitude at well 550

TYPE OF WELL: Drilled Date Constructed July 1954

Depth drilled 99' Depth cased 77'

Section 15

CASING RECORD:
6 inch

FINISH:

AQUIFERS:

WATER LEVEL:
50 feet

PUMPING EQUIPMENT: Type Universal jet H.P. 1 1/2
Capacity 17 G.P.M.

WELL TESTS:
Drawdown 32 ft. after 18 hours G.P.M.
Drawdown ft. after hours G.P.M.

USE OF WATER Irrigation (3 acres) Temp. °F. 19
SOURCE OF INFORMATION GR- 519

DRILLER or DIGGER

ADDITIONAL DATA:

Log X Water Level Measurements Chemical Analysis Aquifer Test

REMARKS:

Red soil & weathered basalt
Fresh basalt, hard

0 to 84
84 to 99

WELL IDENTIFICATION APPLICATION FORM

RECEIVED

JUN - 5 1997

WATER RESOURCES DEPT.
SALEM, OREGON

Linda Lowry
BUYER CURRENT WELL OWNER:

Name: *Fred + Esther Callahan*

Mailing Address: *5730 Lone Oak Rd. SE*

City: *Salim* State: *OR* Zip: *97306* Phone: *(503)*

WELL LOCATION:

County: *Marion* Township: *8S* N or S Range: *3W* E or W

Section: *15* 1/4 1/4 Owner's Well Number: *6R-519B*

Tax Lot Number: *924-00-230* Street Address of Well (if different from above):

Same

WELL INFORMATION: (do not complete remainder of application if well log is available)

Start Card Number: _____ Approx. Construction Date: *July 1954*

Well Constructor: _____

Name of Owner at Time of Construction: *B.J + Dorothy M. Dusenberg*

Well Depth (in feet): *99 ft.* Static Water Level (in feet): *50*

Diameter of Exposed Well Casing (in inches): *6"*

Does this well have a formal water right associated with it? Yes: No: _____

If Yes: Application #: *6R 544* Permit #: _____ Certificate #: *6R 519*

Please Return Completed Form to:

Lisa Juul
Well Identification Program
Oregon Water Resources Department
158 12th Street NE
Salem, OR 97310

For Official Use Only:
Well Tag No. *15439*