

STATE ENGINEER
Salem, Oregon

MA 21
11948

Well Record

STATE WELL NO. 8/3W-15M(2)
COUNTY Marion
APPLICATION NO. GR-4074

OWNER: Ralph H. Lane


MAILING ADDRESS: Route 4, Box 217 Mildred Lane
CITY AND STATE: Salem, Oregon

LOCATION OF WELL: Owner's No.

SW 1/4 NW 1/4 Sec. 15 T. 8 S., R. 3 W., W.M.

Bearing and distance from section or subdivision

corner S. 259' & E. 182' from 1/4 Cor. on West line Sec. 15

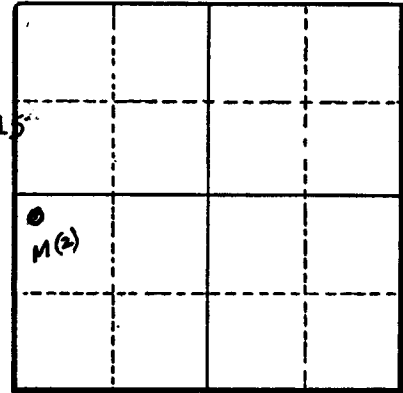

Section 15

Altitude at well Approx. 500

TYPE OF WELL: Drilled Date Constructed 9/50

Depth drilled 96 ft. Depth cased 86 ft.

CASING RECORD:

6 inch casing set to 86 ft.

FINISH:

Unknown

AQUIFERS:

Weathered basalt

WATER LEVEL:

86 feet below surface

PUMPING EQUIPMENT: Type Homart jet H.P. 1 1/2
Capacity 25 G.P.M.

WELL TESTS:

Drawdown	ft. after	hours	G.P.M.
Drawdown	ft. after	hours	G.P.M.

USE OF WATER Irrigation Temp. °F. 19

SOURCE OF INFORMATION Well Registration Statement Cert. # GR-3670

DRILLER or DIGGER Duffield Bros.

ADDITIONAL DATA:

Log Water Level Measurements Chemical Analysis Aquifer Test

REMARKS:

Log	Thickness
Dirt	86
Lava Bed	10