

STATE ENGINEER  
Salem, Oregon

M 111949

# Well Record

STATE WELL NO. 8/3W-15P(1)  
COUNTY Marion  
APPLICATION NO. GR- 140

OWNER: John B. Woods & Sons (Wahl)


MAILING ADDRESS: Box 647

LOCATION OF WELL: Owner's No. 1

CITY AND STATE: Salem, Oregon

SE 1/4 SW 1/4 Sec. 15 T. 8 N. 3 W., W.M.

Bearing and distance from section or subdivision corner 15 ch. N. & 37 ch. E. of SW cor. sec. 15

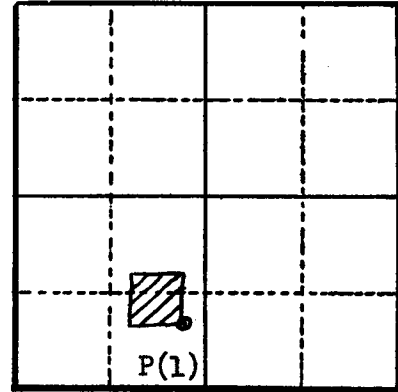

Altitude at well 550 (Interpolated)

TYPE OF WELL: Drilled Date Constructed 3/15/55

Depth drilled 98' Depth cased 43'

Section 15

### CASING RECORD:

8 inch from 0 to 43 feet

### FINISH:

None

### AQUIFERS:

Basalt, 77 to 98 feet

### WATER LEVEL:

26.38 (9/26/63)

PUMPING EQUIPMENT: Type Jacuzzi jet

H.P. 5

Capacity 70 G.P.M.

### WELL TESTS:

Drawdown ..... ft. after ..... hours ..... G.P.M.

Drawdown ..... ft. after ..... hours ..... G.P.M.

USE OF WATER Irrigation (12 acres) Temp. ..... °F. ...., 19

SOURCE OF INFORMATION GR- 330

DRILLER or DIGGER .....

### ADDITIONAL DATA:

Log X Water Level Measurements ..... Chemical Analysis ..... Aquifer Test .....

### REMARKS:

Top soil	0 to 3
Red clay	3 to 25
Red bedrock	25 to 27
Conglomerate -	
weathered basalt	27 to 77
Basalt, sand (WB)	77 to 88
Basalt, med. hard	88 to 98