

STATE ENGINEER
Salem, Oregon

Well Record

STATE WELL NO. 8/3W-15E(1)
COUNTY Marion
APPLICATION NO. GR- 580

M 1 21.....
71952

OWNER: G. W. Harra


MAILING ADDRESS: 745 Stewart St.

LOCATION OF WELL: Owner's No. _____

CITY AND STATE: Salem, Oregon

SW 1/4 NW 1/4 Sec. 15 T. 8 N. S., R. 3 W., W.M.

Bearing and distance from section or subdivision corner N.73°10'E. 1040' from W¹ cor. section 15.

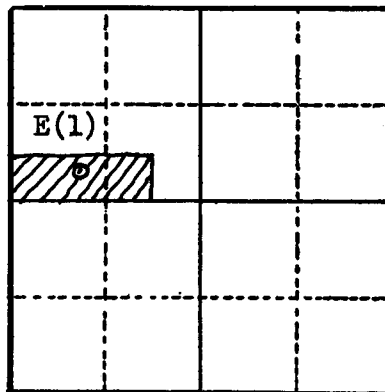

Section 15

Altitude at well 420

TYPE OF WELL: Drilled Date Constructed Oct. 1951

Depth drilled 67' Depth cased 67'

CASING RECORD:
12 inch

FINISH:

AQUIFERS:

WATER LEVEL:
1 1/2 feet

PUMPING EQUIPMENT: Type Centrifugal H.P. 10?
Capacity _____ G.P.M.

WELL TESTS:
Drawdown 1 1/2 ft. after _____ hours 175 G.P.M.
Drawdown _____ ft. after _____ hours _____ G.P.M.

USE OF WATER Irrigation (18 acres) Temp. _____ °F. _____, 19_____

SOURCE OF INFORMATION GR- 552

DRILLER or DIGGER Duffield Bros.

ADDITIONAL DATA:

Log X Water Level Measurements _____ Chemical Analysis _____ Aquifer Test _____

REMARKS:

Red clay & silt	0 to 12
Blue Clay	12 to 21
Loose formation of disintergrated basalt, sandstone and conglomerate	21 to 66
Solid basalt	66 to 67