

STATE ENGINEER
Salem, Oregon

Well Record

STATE WELL NO. 8/3W-16A(5)
COUNTY Marion
APPLICATION NO. GR-3523 ✓


M 1 ? 1 1 2021

OWNER: Roland J. Seeger MAILING ADDRESS: 5120 Seeger Lane

LOCATION OF WELL: Owner's No. Well #2 CITY AND STATE: Salem, Oregon

NE 1/4 NE 1/4 Sec. 16 T. 8 N S., R. 3 W, W.M.

Bearing and distance from section or subdivision corner 750' S. and 1256.53' W.

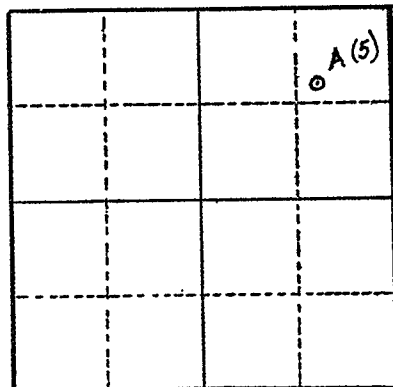

Section 16

Altitude at well _____

TYPE OF WELL: drilled Date Constructed July 10 1941

Depth drilled 96' Depth cased 35'

CASING RECORD:
5 inch from 0 to 35 feet

FINISH:

AQUIFERS:
Weathered basalt
topsoil, clay, boulders, rock ??

WATER LEVEL:
50'

PUMPING EQUIPMENT: Type Jet - Universal H.P. 1
Capacity 23 G.P.M.

WELL TESTS:
Drawdown _____ ft. after _____ hours _____ G.P.M.
Drawdown _____ ft. after _____ hours _____ G.P.M.

USE OF WATER Irrigation Temp. _____ °F. _____, 19_____

SOURCE OF INFORMATION GR-3240

DRILLER or DIGGER _____

ADDITIONAL DATA:
Log x Water Level Measurements _____ Chemical Analysis _____ Aquifer Test _____

REMARKS:

