

STATE ENGINEER
Salem, Oregon

M 1 21..... **Well Record**

STATE WELL NO. 8/3W-16B(1)
COUNTY Marion
APPLICATION NO. GR- 445

OWNER: C.E. & Dorothy Uley


MAILING ADDRESS: 5062 Liberty Rd.

LOCATION OF WELL: Owner's No. _____

CITY AND STATE: Salem, Oregon

NW 1/4 NE 1/4 Sec. 16 T. 8 N. S. R. 3 W., W.M.

Bearing and distance from section or subdivision
corner 2020' W. & 460' S. from NE cor. sec. 16

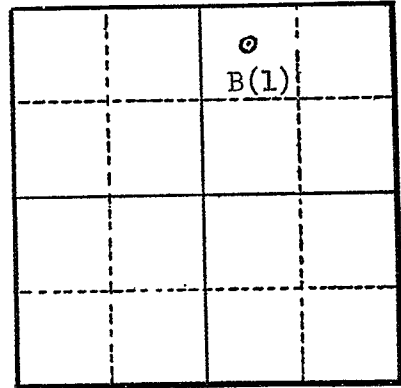

Section 16

Altitude at well 480

TYPE OF WELL: Drilled Date Constructed 5/31/54

Depth drilled 75' Depth cased 61'

CASING RECORD:
6 inch

FINISH:

AQUIFERS:

WATER LEVEL:
20 feet

PUMPING EQUIPMENT: Type Myers jet H.P. 2'
Capacity 27 G.P.M.

WELL TESTS:
Drawdown _____ ft. after _____ hours _____ G.P.M.
Drawdown _____ ft. after _____ hours _____ G.P.M.

USE OF WATER Irrigation (8 acres) Temp. _____ °F. _____, 19.

SOURCE OF INFORMATION GR- 431

DRILLER or DIGGER Harry Robinson

ADDITIONAL DATA:
Log X Water Level Measurements _____ Chemical Analysis _____ Aquifer Test _____

REMARKS:

Top soil 0 to 3
Decomposed basalt 3 to 75
Picked up water from 55 to 75 feet