

STATE ENGINEER
Salem, Oregon

MI 21.....

Well Record

12023

STATE WELL NO. 8/3W-16N ^{G2}
COUNTY MARION
APPLICATION NO. GR-2678

OWNER: Harold A. Rosebraugh


MAILING ADDRESS: 5250 Liberty Road.

LOCATION OF WELL: Owner's No.

CITY AND STATE: Salem, Oregon

^{SW} SE 1/4 NE 1/4 Sec. 16 T. 8 S., R. 3 W., W.M.

Bearing and distance from section or subdivision corner 390' N. & 400' E.

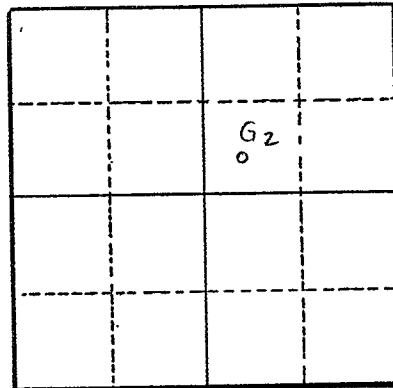

Section 16

Altitude at well

TYPE OF WELL: drilled Date Constructed 1948

Depth drilled 52 Depth cased 52

CASING RECORD:

6-inch

FINISH:

Torch cut slots from 40 to 52

AQUIFERS:

Basalt

WATER LEVEL:

28-feet

PUMPING EQUIPMENT: Type Montgomery Ward Jet H.P. 1
Capacity 10 G.P.M.

WELL TESTS:

Drawdown ft. after hours G.P.M.
Drawdown ft. after hours G.P.M.

USE OF WATER irrigation Temp. °F. 19

SOURCE OF INFORMATION GR-2536

DRILLER or DIGGER Sneed Brothers

ADDITIONAL DATA:

Log Water Level Measurements Chemical Analysis Aquifer Test

REMARKS:

Weathered basalt

0 52