

STATE ENGINEER  
Salem, Oregon

OBSERVATION WELL  
Well Record

STATE WELL NO. 4/2W-18A(1)  
COUNTY Marion  
APPLICATION NO. GR-1841

MARI 1207  
Lowell Berger  
John P. McCarthy

OWNER: \_\_\_\_\_  
John P. McCarthy


MAILING ADDRESS: \_\_\_\_\_  
Star Route, Box 58

LOCATION OF WELL: Owner's No. #1

CITY AND STATE: \_\_\_\_\_  
Newberg, Oregon

NE 1/4 NE 1/4 Sec. 18 T. 4 N. S. R. 2 W., W.M.

Bearing and distance from section or subdivision  
corner 2680' S. 6° W. of NE cor. of Daniel  
Murphy DLC 97

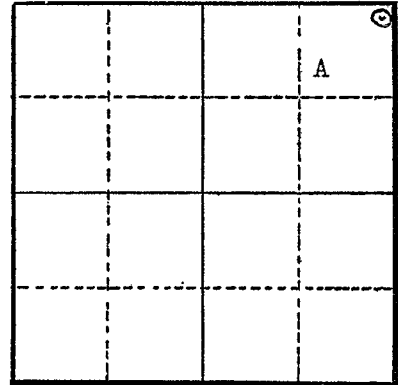

Section 18

Altitude at well 170

TYPE OF WELL: Drilled Date Constructed July '54

Depth drilled \* 179 Depth cased 134

CASING RECORD:

16 inch casing set from 0 to 118 feet  
reduced size ? 118 to 134

FINISH:

Perforated with "J" tool collar between 52.9 and 134 feet

AQUIFERS:

Sands and gravel

WATER LEVEL:

30' (7- -54)

PUMPING EQUIPMENT: Type Layne Bowler Deep Well Turbine H.P. 25  
Capacity 300 G.P.M.

WELL TESTS:

Drawdown \_\_\_\_\_ ft. after \_\_\_\_\_ hours \_\_\_\_\_ G.P.M.  
Drawdown 104 ft. after \_\_\_\_\_ hours 285 G.P.M.

USE OF WATER Irrigation 200 acres Temp. \_\_\_\_\_ °F. \_\_\_\_\_, 19

SOURCE OF INFORMATION GR-1841

DRILLER or DIGGER J. T. Miller - Aurora, Oregon

ADDITIONAL DATA:

Log x Water Level Measurements \_\_\_\_\_ Chemical Analysis \_\_\_\_\_ Aquifer Test \_\_\_\_\_

REMARKS:

\* SEE DEEPENING & RECOND. (2-9-65)

