

STATE ENGINEER
Salem, Oregon

MARI 1208

Well Record


STATE WELL NO. 4/2W-18B(1)
COUNTY Marion
APPLICATION NO. GR-440

OWNER: Edgar J. Mullen MAILING ADDRESS: Star Route

LOCATION OF WELL: Owner's No. CITY AND STATE: Newberg, Oregon

NW 1/4 NE 1/4 Sec. 18 T. 4 N. S, R. 2 E. W., W.M.

Bearing and distance from section or subdivision corner 2000' W. & 1000' S. from NE cor. Sec. 18

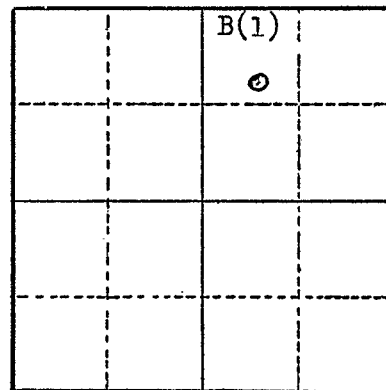

Section 18

Altitude at well 169

TYPE OF WELL: Drilled Date Constructed Apr. 8, '55

Depth drilled 162 Depth cased 162

CASING RECORD:

8 inch

FINISH:

Casing perforated 97-162

AQUIFERS:

WATER LEVEL:

60 4/ /55

PUMPING EQUIPMENT: Type Layne & Bowler Turbine H.P. 15
Capacity 225 G.P.M.

WELL TESTS:

Drawdown ft. after hours G.P.M.

Drawdown ft. after hours G.P.M.

USE OF WATER Irrigation 115 acres Temp. °F. 19

SOURCE OF INFORMATION GR-440

DRILLER or DIGGER

ADDITIONAL DATA:

Log Water Level Measurements Chemical Analysis Aquifer Test

REMARKS:

