

STATE ENGINEER
Salem, Oregon

Well Record

STATE WELL NO. 4/24-18J
COUNTY Marion
APPLICATION NO. GR-3299

MARI 12/0

OWNER: Kirk Brothers


MAILING ADDRESS: Star Route Box 63

LOCATION OF WELL: Owner's No. 1

CITY AND STATE: Newberg, Oregon Pg 1 of 2

NE ¼ SE ¼ Sec. 18 T. 4 N. S., R. 2 W., W.M.

Bearing and distance from section or subdivision corner 910' W. & 2050' N. from SE cor. Sec. 18

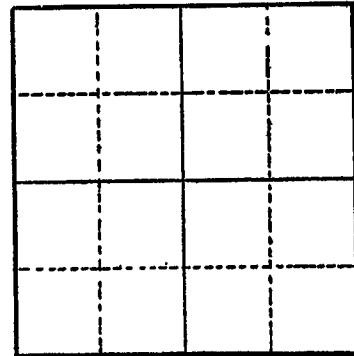

Section

Altitude at well

TYPE OF WELL: drilled Date Constructed 1954

Depth drilled 130 Depth cased 130

CASING RECORD:

18 inch

FINISH:

AQUIFERS:

WATER LEVEL:

18 feet

PUMPING EQUIPMENT: Type Jacuzzi Turbine H.P. 20
Capacity 500 G.P.M.

WELL TESTS:

Drawdown 60 ft. after hours Pumping 450 G.P.M.

Drawdown ft. after hours G.P.M.

USE OF WATER Irrigation Temp. °F., 19.....

SOURCE OF INFORMATION GR-3061

DRILLER or DIGGER J. T. Miller Aurora, Oregon

ADDITIONAL DATA:

Log Water Level Measurements Chemical Analysis Aquifer Test

REMARKS:

STATE ENGINEER
Salem, Oregon

Well Record

STATE WELL NO. 4/2W-18J(1)
COUNTY Marion
APPLICATION NO. _____

MARI:.....
1210

OWNER: Kirk Bros.


MAILING ADDRESS: _____ pg 2 of 2

LOCATION OF WELL: Owner's No. _____

CITY AND STATE: _____

..... $\frac{1}{4}$ $\frac{1}{4}$ Sec. T. N. S, R. E. W., W.M.

Bearing and distance from section or subdivision corner _____

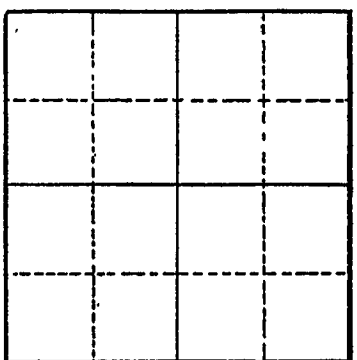

Altitude at well 171

TYPE OF WELL: Drilled Date Constructed 1954

Depth drilled 130 Depth cased _____

Section _____

CASING RECORD:
18 inch

FINISH:

AQUIFERS:

WATER LEVEL:
18 feet below land surface, November, 1954

PUMPING EQUIPMENT: Type Turbine H.P. 20
Capacity _____ G.P.M.

WELL TESTS:
Drawdown _____ ft. after _____ hours _____ G.P.M.
Drawdown _____ ft. after _____ hours _____ G.P.M.

USE OF WATER Irrigation-252 acres Temp. _____ °F. _____, 19_____

SOURCE OF INFORMATION USGS

DRILLER or DIGGER _____

ADDITIONAL DATA:
Log _____ Water Level Measurements _____ Chemical Analysis _____ Aquifer Test _____

REMARKS: