

STATE ENGINEER
Salem, Oregon

MARI 1222

Well Record


STATE WELL NO. 4/2W-19C(1)
COUNTY Marion
APPLICATION NO. GR-895

OWNER: C. James Gooding MAILING ADDRESS: _____

LOCATION OF WELL: Owner's No. 1 CITY AND STATE: St. Paul, Oregon

SW 1/4 NW 1/4 Sec. 19 T. 4 N. S., R. 2 E. W., W.M.

Bearing and distance from section or subdivision corner 3950' W. & 1150' S. from NE cor. Sec. 19

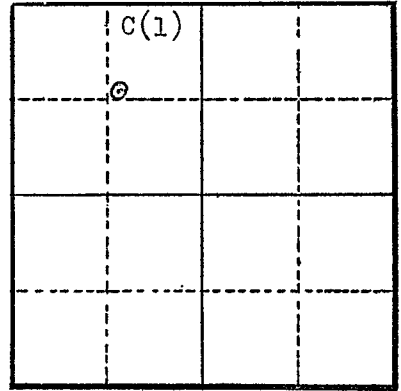

Section 19

Altitude at well 169

TYPE OF WELL: Drilled Date Constructed May '52

Depth drilled 140 Depth cased 140

CASING RECORD:

10" diameter 0 to 140 feet

FINISH:

Liner 12' x 8" perforations 7' on bottom
Perforations 1/4" x 2" slots

AQUIFERS:

Black sand and gravel 280 gallons per minute 136 - 140 feet

WATER LEVEL:

37 feet 5/12/52

PUMPING EQUIPMENT: Type Peerless Line shaft turbine 6" col. H.P. 15 Elec.
Capacity 225 G.P.M.

WELL TESTS:

Drawdown 40 ft. after _____ hours 280 G.P.M.
Drawdown _____ ft. after _____ hours _____ G.P.M.

USE OF WATER Irrigation 66 acres Temp. 55. °F. 19

SOURCE OF INFORMATION Owner

DRILLER or DIGGER J. T. Miller

ADDITIONAL DATA:

Log Water Level Measurements _____ Chemical Analysis _____ Aquifer Test _____

REMARKS:

