

STATE ENGINEER
Salem, Oregon


M 131
1225 Well Record

STATE WELL NO. 8/3W-21G
COUNTY ~~Multnomah~~ Marion
APPLICATION NO. GR-4274

OWNER: U. S. National Bank of Portland
Trustee

MAILING ADDRESS: P. O. Box 4410
CITY AND STATE: Portland, Oregon

LOCATION OF WELL: Owner's No. _____
SW 1/4 NE 1/4 Sec. 21 T. 8 N. S. R. 3 W., W.M.
Bearing and distance from section or subdivision
corner approximately 600 feet north of center

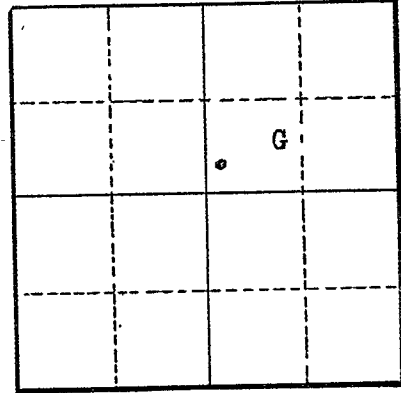

Section 21

Altitude at well 500 feet

TYPE OF WELL: Drilled Date Constructed Aug. 1953

Depth drilled 63 feet Depth cased _____

CASING RECORD:

8 inch casing

FINISH:

AQUIFERS:

WATER LEVEL:

PUMPING EQUIPMENT: Type Berkley H.P. _____
Capacity _____ G.P.M.

WELL TESTS:
Drawdown _____ ft. after _____ hours _____ G.P.M.
Drawdown _____ ft. after _____ hours _____ G.P.M.

USE OF WATER Irrigation Temp. _____ °F. _____, 19.

SOURCE OF INFORMATION GR-4126
DRILLER or DIGGER West Well Drilling, Salem, Oregon

ADDITIONAL DATA:
Log (NA) Water Level Measurements _____ Chemical Analysis _____ Aquifer Test _____

REMARKS:

Rt. 4, Box 298 (Mr. Siewert)