

STATE ENGINEER  
Salem, Oregon

MARI 1226  
MARI.....

# Well Record


STATE WELL NO. 4/2W-19G(2)  
COUNTY Marion  
APPLICATION NO. GR-241

OWNER: Lester W. & Kathryn Ernst MAILING ADDRESS: \_\_\_\_\_

LOCATION OF WELL: Owner's No. #2 CITY AND STATE: St. Paul, Oregon

SW 1/4 NE 1/4 Sec. 19 T. 4 N. S, R. 2 W., W.M.

Bearing and distance from section or subdivision corner 1100' N. & 500' E. from the center of Sec. 19

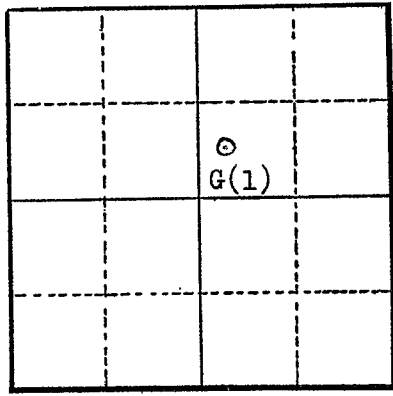

Section 19

Altitude at well 167 feet Interpolated

TYPE OF WELL: Drilled Date Constructed 4/20/52

Depth drilled 125 Depth cased 123

### CASING RECORD:

8 inch casing set from 0 to 123 feet

### FINISH:

None

### AQUIFERS:

62 - 98 feet  
Sand and small gravel 123 - 125 feet

### WATER LEVEL:

38 feet below land surface 5/12/52

PUMPING EQUIPMENT: Type Peerless Deep well turbine H.P. 10  
Capacity 185 G.P.M.

### WELL TESTS:

Drawdown 85 ft. after \_\_\_\_\_ hours pumping 350 G.P.M.  
Drawdown \_\_\_\_\_ ft. after \_\_\_\_\_ hours \_\_\_\_\_ G.P.M.

USE OF WATER Municipal Temp. \_\_\_\_\_ °F. \_\_\_\_\_, 19

SOURCE OF INFORMATION Registration Statement GR-241

DRILLER or DIGGER J. T. Miller P. O. Box 198 Aurora, Oregon

### ADDITIONAL DATA:

Log Yes Water Level Measurements \_\_\_\_\_ Chemical Analysis \_\_\_\_\_ Aquifer Test \_\_\_\_\_

### REMARKS:

