

STATE ENGINEER
Salem, Oregon


MAR 12 1949

Well Record

STATE WELL NO. 4/2W - 19H
COUNTY MARION
APPLICATION NO. GR-2161

OWNER: Raymond P. Smith Secretary-Treasurer MAILING ADDRESS: St. Paul
of the St. Paul Cemetery Association CITY AND STATE: Oregon

LOCATION OF WELL: Owner's No. _____
SE 1/4 NE 1/4 Sec. 19 T. 4 N. S., R. 2 W., W.M.
Bearing and distance from section or subdivision
corner 2400' S. and 250' W.

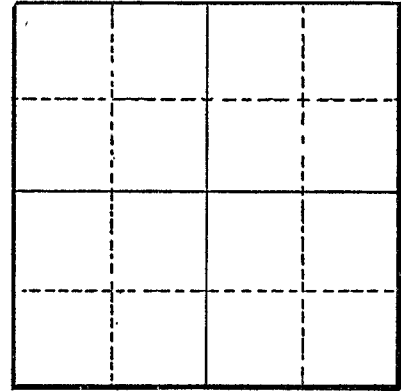

Altitude at well 169

TYPE OF WELL: Drilled Date Constructed 1949
Depth drilled 125 Depth cased 124

Section _____

CASING RECORD:

6-Inches

FINISH:

AQUIFERS: Clay and sand

WATER LEVEL: 32-Feet (5-17-49)

PUMPING EQUIPMENT: Type Fairbanks Morse Turbine H.P. 5
Capacity 80 G.P.M.

WELL TESTS:
Drawdown 90 ft. after _____ hours Pumping 80 G.P.M.
Drawdown _____ ft. after _____ hours _____ G.P.M.

USE OF WATER Irrigation 4 acres Temp. _____ °F. _____, 19____

SOURCE OF INFORMATION GR-2071

DRILLER or DIGGER J. T. Miller, Box 198, Aurora, Oregon

ADDITIONAL DATA:
Log X Water Level Measurements _____ Chemical Analysis _____ Aquifer Test _____

REMARKS:

