

STATE ENGINEER
Salem, Oregon

MARI 1230

Well Record


STATE WELL NO. 4/2W-19G(1)
COUNTY Marion
APPLICATION NO. GR-241

OWNER: Lester W. & Kathryn Ernst MAILING ADDRESS: _____

LOCATION OF WELL: Owner's No. #1 CITY AND STATE: St. Paul, Oregon

SE 1/4 NE 1/4 Sec. 19 T. 4 S., R. 2 W., W.M.

Bearing and distance from section or subdivision corner 1200' W. & 250' N. from E 1/4 cor. Sec. 19

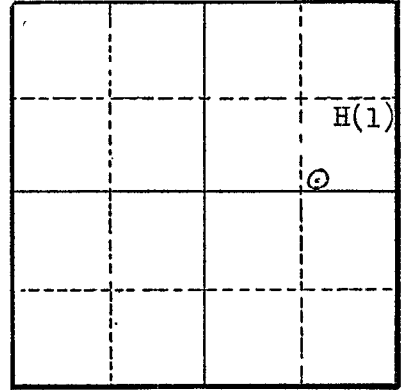

Section 19

Altitude at well 167' Interpolated

TYPE OF WELL: Drilled Date Constructed 1916

Depth drilled 170' Depth cased 170'

CASING RECORD:

5 5/8" steel casing set from 0 to 170 feet

FINISH:

unknown

AQUIFERS:

unknown

WATER LEVEL:

39 feet below land surface

PUMPING EQUIPMENT: Type Pomona deep well turbine H.P. 5
Capacity 110 G.P.M.

WELL TESTS:

Drawdown 60 ft. after _____ hours pumping 110 G.P.M.
Drawdown _____ ft. after _____ hours _____ G.P.M.

USE OF WATER Municipal 110 gpm Temp. _____ °F, 19
SOURCE OF INFORMATION Registration Statement GR-241

DRILLER or DIGGER _____

ADDITIONAL DATA:

Log NO Water Level Measurements _____ Chemical Analysis _____ Aquifer Test _____

REMARKS: