

STATE ENGINEER
Salem, Oregon

MIRI.....

12301

Well Record

STATE WELL NO. 8/3W-22H /
COUNTY Marion
APPLICATION NO. GR-4177

OWNER: Ernestine M. McNevey


MAILING ADDRESS: Route 4, Box 197

LOCATION OF WELL: Owner's No.

CITY AND STATE: Salem, Oregon

SE 1/4 NE 1/4 Sec. 22 T. 8 S., R. 3 W., W.M.

Bearing and distance from section or subdivision
corner 250' W. & 75' N. from E 1/4 Cor. Sec. 22

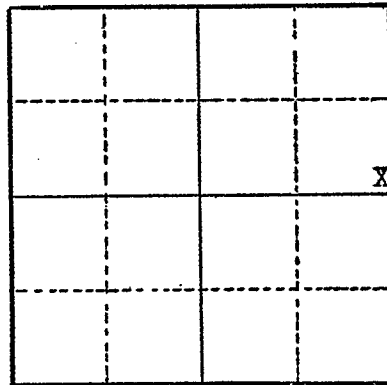

Section 22

Altitude at well

TYPE OF WELL: Dug Date Constructed 9/20/51

Depth drilled 4 ft. Depth cased 20' x 40'

CASING RECORD:

Sump 20' x 40' x 4'

FINISH:

AQUIFERS:

WATER LEVEL:

Land surface

PUMPING EQUIPMENT: Type No name centrifugal H.P. 1/4
Capacity 250 G.P.M.

WELL TESTS:

Drawdown ft. after hours G.P.M.
Drawdown ft. after hours G.P.M.

USE OF WATER Irrigation Temp. °F., 19

SOURCE OF INFORMATION Well Registration Statement Cert. # GR-3736

DRILLER or DIGGER

ADDITIONAL DATA:

Log Water Level Measurements Chemical Analysis Aquifer Test

REMARKS:

Log: Soil & clay

Depth to Bottom
4