

STATE ENGINEER
Salem, Oregon

Well Record

STATE WELL NO. 4/2W-20M(1)
COUNTY Marion
APPLICATION NO. G.R. 3372

MARI...
1242
L. J. Kirk

OWNER: L. J. Kirk
MAILING ADDRESS:
CITY AND STATE:


LOCATION OF WELL: Owner's No. _____
_____ 1/4 Sec. _____ T. _____ N. _____ E.
S., R. _____ W., W.M.

Bearing and distance from section or subdivision
corner _____

Altitude at well 160

TYPE OF WELL: Drilled Date Constructed 1951

Depth drilled 134 Depth cased _____

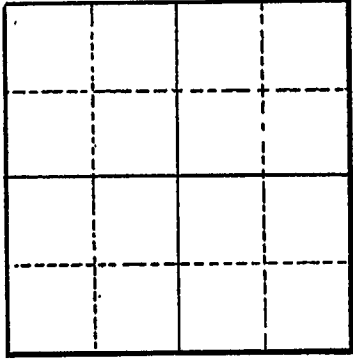

Section _____

CASING RECORD:

18 inch

FINISH:

Screened 115 to 120

AQUIFERS:

Coarse sand and fine gravel from 112 to 128
Gravel from 129 to 134

WATER LEVEL:

30 feet below land surface, October, 1951

PUMPING EQUIPMENT: Type

Turbine H.P. 30

Capacity _____ G.P.M.

WELL TESTS:

Drawdown _____ ft. after _____ hours _____ G.P.M.

Drawdown _____ ft. after _____ hours _____ G.P.M.

USE OF WATER Irrigation--145 acres Temp. _____ °F. _____, 19____

SOURCE OF INFORMATION USGS

DRILLER or DIGGER _____

ADDITIONAL DATA:

Log Water Level Measurements _____ Chemical Analysis _____ Aquifer Test _____

REMARKS:

STATE ENGINEER
Salem, Oregon

Well Record

STATE WELL NO. 4/2W-20M
COUNTY Marion
APPLICATION NO. GR-3372

MARI.
1242

OWNER: Lester J. Kirk


MAILING ADDRESS: St. Route, Box 35 Pg 3 of 4

LOCATION OF WELL: Owner's No. _____

CITY AND STATE: St. Paul, Oregon

NW 1/4 SW 1/4 Sec. 20 T. 4 S., R. 2 W., W.M.

Bearing and distance from section or subdivision corner 1300' W. and 2600' N.

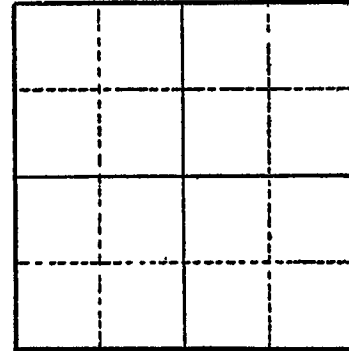

Section _____

Altitude at well _____

TYPE OF WELL: drilled Date Constructed 1951

Depth drilled 134' Depth cased 134'

CASING RECORD:
18"

FINISH:

screen perforated from 115 to 120

AQUIFERS:

sand, clay gravel,

WATER LEVEL:

30'

PUMPING EQUIPMENT: Type Turbine H.P. 30

Capacity 500 G.P.M.

WELL TESTS:

Drawdown 76 ft. after _____ hours pumping 140 G.P.M.

Drawdown _____ ft. after _____ hours _____ G.P.M.

USE OF WATER Irrigation Temp. _____ °F., 19

SOURCE OF INFORMATION GR-3118

DRILLER or DIGGER J. T. Miller

ADDITIONAL DATA:

Log X Water Level Measurements _____ Chemical Analysis _____ Aquifer Test _____

REMARKS:

