

STATE ENGINEER
Salem, Oregon

1259
MARI.....

Well Record

STATE WELL NO. 4/2W-22E(1)
COUNTY Marion
APPLICATION NO. GR-488


OWNER: Geo. & Mary Fick
MAILING ADDRESS: _____
CITY AND STATE: Portland, Oregon

LOCATION OF WELL: Owner's No. _____
SW 1/4 NW 1/4 Sec. 22 T. 4 N. S, R. 2 E. W., W.M.

Bearing and distance from section or subdivision corner _____

Altitude at well 152

TYPE OF WELL: Drilled Date Constructed Sept. '48
Depth drilled 214 Depth cased 214

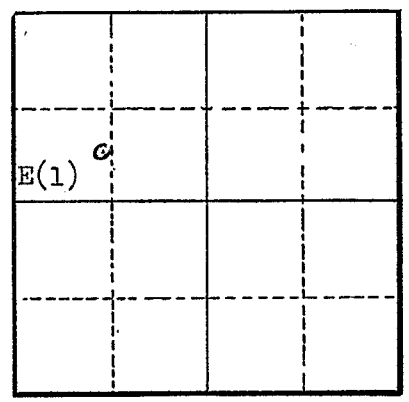

Section 22

CASING RECORD:

10 inch

FINISH:

Casing perforated 125-127 202-212

AQUIFERS:

WATER LEVEL:

40' Sept. '48

PUMPING EQUIPMENT: Type Peerless turbine H.P. 15
Capacity 250-300 G.P.M.

WELL TESTS:

Drawdown _____ ft. after _____ hours _____ G.P.M.
Drawdown _____ ft. after _____ hours _____ G.P.M.

USE OF WATER Irrigation 70 acres Temp. _____ °F. _____, 19

SOURCE OF INFORMATION GR-488

DRILLER or DIGGER R.J. Strasser

ADDITIONAL DATA:

Log Water Level Measurements _____ Chemical Analysis _____ Aquifer Test _____

REMARKS:

