

STATE ENGINEER  
Salem, Oregon

# Well Record

STATE WELL NO. 4/2W-22K  
COUNTY MARION  
~~APPLICATION NO.~~ GR-2514

1261  
MARION

OWNER: Herb Kelsey


MAILING ADDRESS: Rt 1, Box 378

LOCATION OF WELL: Owner's No. \_\_\_\_\_

CITY AND STATE: Woodburn, Oregon

NW  $\frac{1}{4}$  NE  $\frac{1}{4}$  Sec. 22 T. 4 S., R. 2 W., W.M.

Bearing and distance from section or subdivision  
corner 1660' W & 1050' S from NE corner Section 22

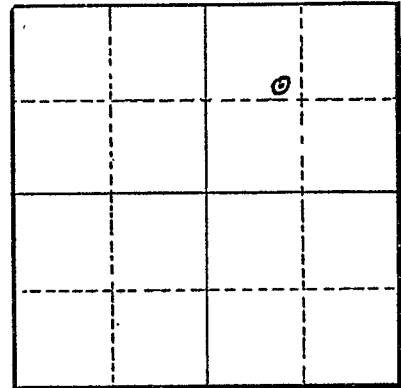

Section 22

Altitude at well \_\_\_\_\_

TYPE OF WELL: Drilled Date Constructed 1955

Depth drilled 145' Depth cased 145'

### CASING RECORD:

18-inch

### FINISH:

45 holes perforated 114' to 115'  
Gravel Pack 129½' to 145'

### AQUIFERS:

### WATER LEVEL:

30'

PUMPING EQUIPMENT: Type Multi-Stage Turbine H.P. 40  
Capacity 800 G.P.M.

### WELL TESTS:

Drawdown 60 ft. after \_\_\_\_\_ hours 600 G.P.M.  
Drawdown 85 ft. after \_\_\_\_\_ hours 680 G.P.M.

USE OF WATER Irrigation Temp. \_\_\_\_\_ °F., 19\_\_\_\_\_

SOURCE OF INFORMATION GR-3833

DRILLER or DIGGER J. T. Miller

### ADDITIONAL DATA:

Log  Water Level Measurements \_\_\_\_\_ Chemical Analysis \_\_\_\_\_ Aquifer Test \_\_\_\_\_

### REMARKS:

