

STATE ENGINEER
Salem, Oregon

MAR... 12672 Well Record

STATE WELL NO. 8/3W-27R,
COUNTY Marion
APPLICATION NO. GR-3255


OWNER: William H. Koellmann

MAILING ADDRESS: Route 4, Box 566

LOCATION OF WELL: Owner's No.

CITY AND STATE: Salem, Oregon

SE 1/4 SE 1/4 Sec. 27 T. 8 S, R. 3 W., W.M.

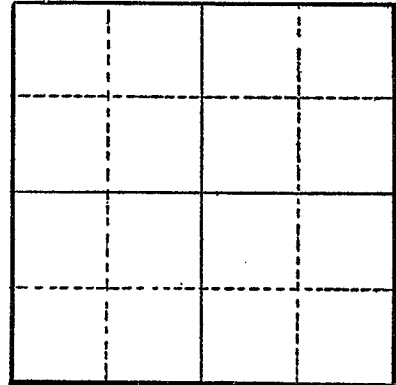

Bearing and distance from section or subdivision corner 145' S. & 75' W. of NE Corner Lot 9

Altitude at well

Section

TYPE OF WELL: drilled Date Constructed 1953

Depth drilled 60 Depth cased 17

CASING RECORD:

6 inch

FINISH:

AQUIFERS:

WATER LEVEL:

17 feet

PUMPING EQUIPMENT: Type Sears, deep-well jet H.P. 1/2
Capacity 10 G.P.M.

WELL TESTS:

Drawdown ft. after hours G.P.M.
Drawdown ft. after hours G.P.M.

USE OF WATER Irrigation Temp. °F. 19

SOURCE OF INFORMATION GR-3028

DRILLER or DIGGER Sneed & Sons, Brooks St., Salem, Oregon

ADDITIONAL DATA:

Log Water Level Measurements Chemical Analysis Aquifer Test

REMARKS: