

STATE ENGINEER
Salem, Oregon

MAR 12 1970

Well Record

STATE WELL NO. 4/2W-230 1
COUNTY Marion
APPLICATION NO. GR-1249


GR-1206

OWNER: John Fick
MAILING ADDRESS: 868 Young St.

LOCATION OF WELL: Owner's No. #1
CITY AND STATE: Woodburn, Oregon

SW 1/4 SE 1/4 Sec. 23 T. 4 N. R. 2 W., W.M.

Bearing and distance from section or subdivision
corner 2050' W. & 200' N. from SE cor. Sec. 23.

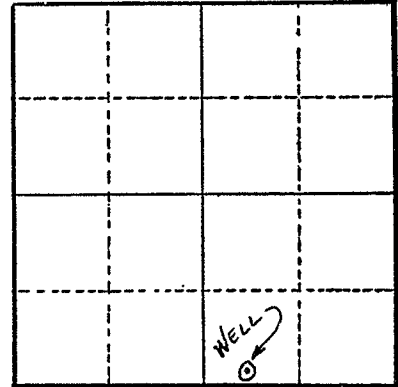

Section 23

Altitude at well 150 ft.

TYPE OF WELL: Drilled Date Constructed 1951

Depth drilled 80 ft. Depth cased 80 ft.

CASING RECORD:

18 in. steel casing from 0 to 80 ft.
6 in. inner casing from 0 to ??
Gravel pack between the two.

FINISH:

AQUIFERS:

WATER LEVEL:

28 ft. (8-51)

PUMPING EQUIPMENT: Type Peerless turbine H.P. 30
Capacity 650 G.P.M.

WELL TESTS:

Drawdown 64 ft. after 940 hours G.P.M.
Drawdown 52 ft. after 600 hours G.P.M.

USE OF WATER Irrigation Temp. °F. 19

SOURCE OF INFORMATION G. R. Record

DRILLER or DIGGER J. T. Miller

ADDITIONAL DATA:

Log Water Level Measurements Chemical Analysis Aquifer Test

REMARKS:

Log: Surface soil 0 to 4 ft.
Yellow clay 4 to 18 ft.
Gray clay 18 to 23 ft.
Surface water 23 to 27 ft.
Yellow clay 27 to 40 ft.
Gray clay 40 to 65 ft.
Blue clay 65 to 75 ft.
Red & black sand 75 to 78 ft.
Small gravel 78 to 80 ft.
Irrigation of 129.5 acres.