

STATE ENGINEER
Salem, Oregon

Well Record

STATE WELL NO. 4/2W-25P(1)
COUNTY Marion
APPLICATION NO. GR-361


MARI 1292

OWNER: Carl Brooks
MAILING ADDRESS: Route 1, Box 150

LOCATION OF WELL: Owner's No. _____
CITY AND STATE: Aurora, Oregon

SE 1/4 SW 1/4 Sec. 25 T. 4 N. S. R. 2 E. W., W.M.

Bearing and distance from section or subdivision
corner 675' W. & 1200' N. from S 1/4 cor. Sec. 25

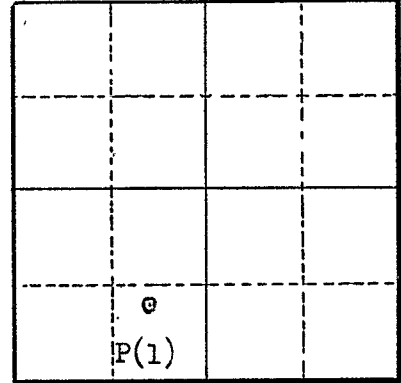

Altitude at well 175

TYPE OF WELL: Drilled Date Constructed June '53

Depth drilled 120 Depth cased 120

Section 25

CASING RECORD:

6 inch

FINISH:

Casing perforated 95-115

AQUIFERS:

WATER LEVEL:

15' June 1953

PUMPING EQUIPMENT: Type Turbine H.P. 5
Capacity 100 G.P.M.

WELL TESTS:

Drawdown _____ ft. after _____ hours _____ G.P.M.
Drawdown _____ ft. after _____ hours _____ G.P.M.

USE OF WATER Irrigation 9 acres Temp. _____ °F., 19

SOURCE OF INFORMATION GR-
DRILLER or DIGGER E. L. Koeneman Hubbard, Oregon

ADDITIONAL DATA:

Log No Water Level Measurements _____ Chemical Analysis _____ Aquifer Test _____

REMARKS: