

STATE ENGINEER  
Salem, Oregon

# Well Record


STATE WELL NO. 4/2W-25R  
COUNTY Marion  
APPLICATION NO. GR-3620

MARION 1293

OWNER: Felix D. Hassing MAILING ADDRESS: Route 1, Box 166  
CITY AND STATE: Aurora, Oregon

LOCATION OF WELL: Owner's No. \_\_\_\_\_  
SE 1/4 SE 1/4 Sec. 25 T. 4 S., R. 2 W., W.M.

Bearing and distance from section or subdivision  
corner Well is S. 1716 feet and W. 743 ft. from  
1/4 corner East line 25

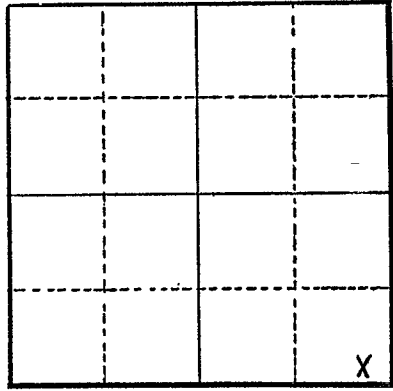

Section 25

Altitude at well \_\_\_\_\_

TYPE OF WELL: Drilled Date Constructed Oct., 1944  
Depth drilled 142 ft. Depth cased 142 ft.

### CASING RECORD:

8 inch steel casing set to 142 feet

### FINISH:

1 inch perforations, 8 to the ft. from 70 to 78 ft.

### AQUIFERS:

### WATER LEVEL:

24 feet below surface

PUMPING EQUIPMENT: Type Layne & Boller H.P. 10  
Capacity 400 G.P.M.

### WELL TESTS:

Drawdown 48 ft. after \_\_\_\_\_ hours 390 G.P.M.  
Drawdown 27 ft. after \_\_\_\_\_ hours 250 G.P.M.

USE OF WATER Irrigation Temp. \_\_\_\_\_ °F., 19 \_\_\_\_\_

SOURCE OF INFORMATION Well Registration Statement

DRILLER or DIGGER Pete Horning

### ADDITIONAL DATA:

Log \_\_\_\_\_ Water Level Measurements \_\_\_\_\_ Chemical Analysis \_\_\_\_\_ Aquifer Test \_\_\_\_\_

### REMARKS: