

STATE ENGINEER
Salem, Oregon

M 1 21
Well Record
12959

STATE WELL NO. 8/3W-33K(1)
COUNTY Marion
APPLICATION NO. G-1509

OWNER: W. A. Cosman


MAILING ADDRESS: Rt. 3 Box 792

LOCATION OF WELL: Owner's No.

CITY AND STATE: Salem, Oregon

NW 1/4 SE 1/4 Sec. 33 T. 8 S., R. 3 W., W.M.

Bearing and distance from section or subdivision corner 922' S. & 1997' W. from E 1/4 cor. sec. 33

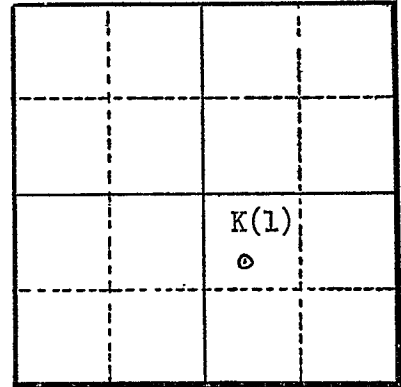

Altitude at well

Section 33

TYPE OF WELL: Drilled Date Constructed

Depth drilled 90' Depth cased

CASING RECORD:
6 inch

FINISH:

AQUIFERS:

WATER LEVEL:
37 feet

PUMPING EQUIPMENT: Type Jet H.P. 2
Capacity G.P.M.

WELL TESTS:
Drawdown ft. after hours G.P.M.
Drawdown ft. after hours G.P.M.

USE OF WATER Dom., Stock & Irrigation Temp. °F., 19

SOURCE OF INFORMATION Perm. G-1380

DRILLER or DIGGER

ADDITIONAL DATA:
Log NA Water Level Measurements Chemical Analysis Aquifer Test

REMARKS: