

STATE ENGINEER
Salem, Oregon

M.L.H.
12960

Well Record

STATE WELL NO. 8/3W-33K(2)
COUNTY Marion
APPLICATION NO. GR-2078

OWNER: Mrs. May Grape


MAILING ADDRESS: Rt. 3 Box 793

LOCATION OF WELL: Owner's No.

CITY AND STATE: Salem, Oregon

NW 1/4 SE 1/4 Sec. 33 T. 8 S., R. 3 W., W.M.

Bearing and distance from section or subdivision corner 250' E. & 100' S. from Center sec. 33

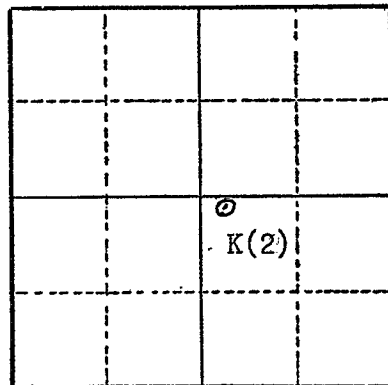

Section 33

Altitude at well 700

TYPE OF WELL: Drilled Date Constructed 1952

Depth drilled 261' Depth cased 60'

CASING RECORD:
8 inch

FINISH:

AQUIFERS:

Rock

WATER LEVEL:
90 feet

PUMPING EQUIPMENT: Type Jacuzzi submersible H.P. 3 1/8
Capacity 25 G.P.M.

WELL TESTS:
Drawdown 90 ft. after 40 hours G.P.M.
Drawdown ft. after hours G.P.M.

USE OF WATER Irrigation Temp. °F. 19

SOURCE OF INFORMATION
DRILLER or DIGGER Harry Evans

ADDITIONAL DATA:
Log Water Level Measurements Chemical Analysis Aquifer Test

REMARKS:
Red type hill soil 0 to 40
Black brown to black rock 40 to 80
Hard black & grey basalt rock 80 to 261