

STATE ENGINEER
Salem, Oregon

M 121...
Well Record
12961

STATE WELL NO. 8/3W - 33P /
COUNTY ~~MASTON~~
APPLICATION NO. GR-1975

OWNER: Robert M. Chambers


MAILING
ADDRESS: 1830 N. Commercial

LOCATION OF WELL: Owner's No.

CITY AND
STATE: Salem, Oregon

SE $\frac{1}{4}$ SW $\frac{1}{4}$ Sec. 33 T. 8 N. S., R. 3 E. W.M.

Bearing and distance from section or subdivision
corner 1760' E. & 470' N.

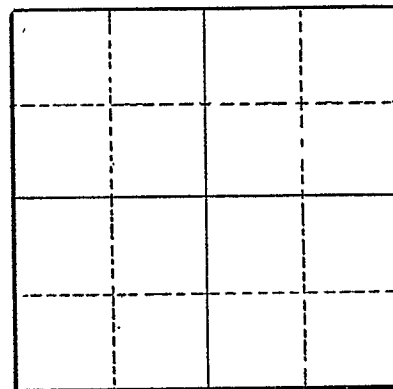

Section

Altitude at well

TYPE OF WELL: Drilled Date Constructed 1953

Depth drilled 146' Depth cased 146'

CASING RECORD:

10-inch

FINISH:

AQUIFERS:

Rock

WATER LEVEL:

46'

PUMPING EQUIPMENT: Type Jacuzzi Jet H.P. $\frac{1}{2}$
Capacity 50 G.P.M.

WELL TESTS:

Drawdown ft. after hours G.P.M.
Drawdown ft. after hours G.P.M.

USE OF WATER Irrigation Temp. °F., 19

SOURCE OF INFORMATION GR-1906

DRILLER or DIGGER

ADDITIONAL DATA:

Log Water Level Measurements Chemical Analysis Aquifer Test

REMARKS:

Rock fault at 76' depth gives all flow for well.

Eugene Contact WSB
76 ft.?