

STATE ENGINEER
Salem, Oregon

Well Record

STATE WELL NO. 8/3W - 34C
COUNTY Malheur
APPLICATION NO. GR-2200

OWNER: E. Marjorie A. Chandler


MAILING ADDRESS: P. O. Box 6344

LOCATION OF WELL: Owner's No. _____

CITY AND STATE: Tigard, Oregon

NE $\frac{1}{4}$ NW $\frac{1}{4}$ Sec. 34 T. 8 S., R. 3 E., W.M.

Bearing and distance from section or subdivision
corner 760' W. and 80' S. fr N $\frac{1}{4}$ cor(?)

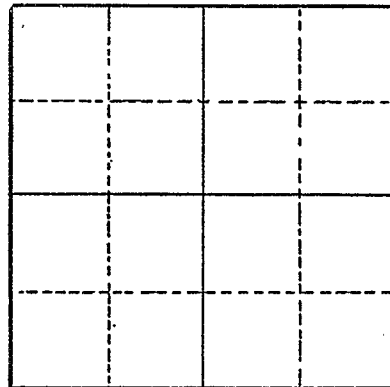

Altitude at well _____

TYPE OF WELL: Drilled Date Constructed 1952

Depth drilled 78 Depth cased 14

Section _____

CASING RECORD:

8-Inch

FINISH:

AQUIFERS:

Soil and rock

WATER LEVEL:

35-Feet

PUMPING EQUIPMENT: Type Meyers Piston Pump H.P. 1
Capacity 40 G.P.M.

WELL TESTS:

Drawdown _____ ft. after _____ hours _____ G.P.M.

Drawdown _____ ft. after _____ hours _____ G.P.M.

USE OF WATER Irrigation Temp. _____ °F. _____, 19_____

SOURCE OF INFORMATION GR-2105

DRILLER or DIGGER Snead Brothers

ADDITIONAL DATA:

Log X Water Level Measurements _____ Chemical Analysis _____ Aquifer Test _____

REMARKS:

Soil 0 14
Rock 14 78