

STATE ENGINEER  
Salem, Oregon

MARI. 1299 Well Record  
6-6175


STATE WELL NO. 4/2W-26B(1)  
COUNTY Marion  
APPLICATION NO. GR-205

OWNER: Prosper J. Berning MAILING ADDRESS: Route 1, Box 335

LOCATION OF WELL: Owner's No. #1 CITY AND STATE: Woodburn, Oregon

NW 1/4 NE 1/4 Sec. 26 T. 4 N. S. R. 2 E. W., W.M.

Bearing and distance from section or subdivision corner S 66° 37' E. S 385' & N. 22° 45' E. 548.4' from NW cor. Barnabee DLC 50

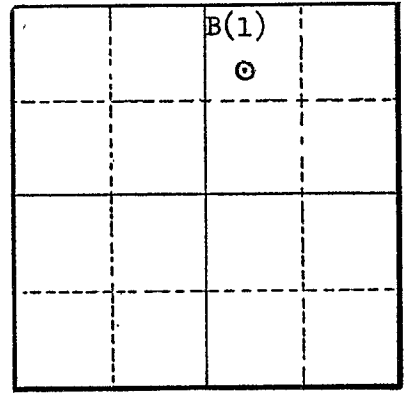

Section 26

Altitude at well 175' Interpolated

TYPE OF WELL: Drilled Date Constructed 6/13/55

Depth drilled 86 Depth cased 70

CASING RECORD:

10 inch casing set from 0 to 70 feet

FINISH:

None

AQUIFERS:

Sands from 18 to 28 feet and 72 to 86 feet

WATER LEVEL:

33 feet below land surface June 24, 1955

PUMPING EQUIPMENT: Type Turbine H.P. 15  
Capacity 250 G.P.M.

WELL TESTS:

Drawdown 11 ft. after hours pumping 300 G.P.M.  
Drawdown ft. after hours G.P.M.

USE OF WATER Irrigation 47 acres Temp. °F., 19

SOURCE OF INFORMATION Registration Statement GR-205

DRILLER or DIGGER J. T. Miller Hubbard, Oregon

ADDITIONAL DATA:

Log  Water Level Measurements Chemical Analysis Aquifer Test

REMARKS: