

STATE ENGINEER
Salem, Oregon

Well Record

STATE WELL NO. 4/2W-26G(1)
COUNTY Marion
APPLICATION NO. GR-310


MARION 1304

OWNER: Charles Newton Davis MAILING ADDRESS: _____

LOCATION OF WELL: Owner's No. 1 CITY AND STATE: Woodburn, Oregon

SW $\frac{1}{4}$ NE $\frac{1}{4}$ Sec. 26 T. 4 N. S., R. 2 E. W., W.M.

Bearing and distance from section or subdivision corner 76 $\frac{1}{2}$ chains S. 66° 37' E. & 16 $\frac{1}{2}$ chains due south from J. Barnabie DLC at the NW cor. of said section

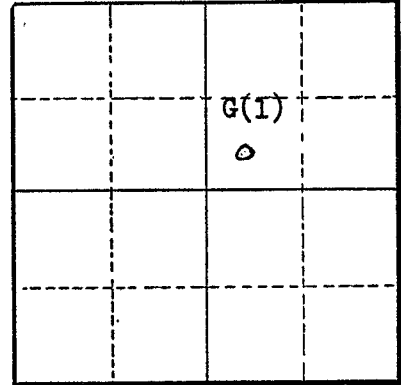

Section 26

Altitude at well 175' Interpolated

TYPE OF WELL: Drilled Date Constructed 9-24-46

Depth drilled 71 124 Depth cased 71 123.5

CASING RECORD:

12 inch concrete tile from 0 to 71 feet *See log of deepening*

FINISH:

None

AQUIFERS:

Black sand and water

WATER LEVEL:

24 feet below land surface 12 ft

PUMPING EQUIPMENT: Type Layne Bowler H.P. 7 $\frac{1}{2}$
Capacity 175 G.P.M.

WELL TESTS:

Drawdown _____ ft. after _____ hours _____ G.P.M.
Drawdown _____ ft. after _____ hours _____ G.P.M.

USE OF WATER Irrigation 40 acres Temp. _____ °F. _____, 19____

SOURCE OF INFORMATION Registration Statement GR-310

DRILLER or DIGGER _____

ADDITIONAL DATA:

Log No Water Level Measurements _____ Chemical Analysis _____ Aquifer Test _____

REMARKS:

*This well deepened by Milo Schneider 4-8-69
See log received Oct. 10, 1969 Depth 124 ft. 4-30-69*

