

STATE ENGINEER
Salem, Oregon

MARI...1308

Well Record


STATE WELL NO. 4/2W-26K(1)
COUNTY Marion
APPLICATION NO. GR-360

OWNER: Merton Imes MAILING ADDRESS: _____

LOCATION OF WELL: Owner's No. _____ CITY AND STATE: Woodburn, Oregon

NW $\frac{1}{4}$ SE $\frac{1}{4}$ Sec. 26 T. 4 S., R. 2 W., W.M.

Bearing and distance from section or subdivision corner 1400' W. & 1650' N. from SE cor. of Sec. 26

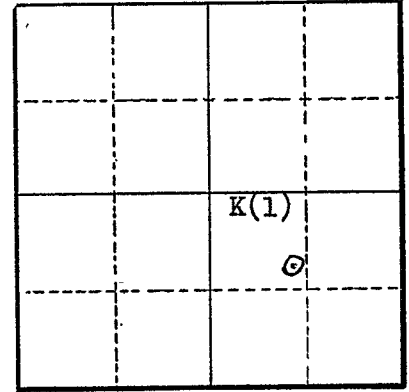

Section 26

Altitude at well 170

TYPE OF WELL: Drilled Date Constructed 8-14-52

Depth drilled 140 Depth cased _____

CASING RECORD:

10 inch

FINISH:

Casing perforated 85-105 feet

AQUIFERS:

Black sand

WATER LEVEL:

30 August 1955

PUMPING EQUIPMENT: Type Jacuzzi turbine H.P. 20
Capacity 500 G.P.M.

WELL TESTS:

Drawdown _____ ft. after _____ hours _____ G.P.M.
Drawdown _____ ft. after _____ hours _____ G.P.M.

USE OF WATER Irrigation Temp. _____ °F., 19 _____

SOURCE OF INFORMATION GR

DRILLER or DIGGER E. L. Koeneman, Hubbard, Oregon

ADDITIONAL DATA:

Log Water Level Measurements _____ Chemical Analysis _____ Aquifer Test _____

REMARKS:

