

STATE ENGINEER
Salem, Oregon

MARI/31

Well Record

STATE WELL NO. 3/1W-32R
COUNTY Marion
APPLICATION NO. GR-3351

OWNER: Roy R. Smith & Robert Hubbard


MAILING ADDRESS: Route 2, Box 188

LOCATION OF WELL: Owner's No.

CITY AND STATE: Aurora, Oregon

SE 1/4 SE 1/4 Sec. 32 T. 3 N. S., R. 1 E. W., W.M.

Bearing and distance from section or subdivision corner 350' N. and 680' W

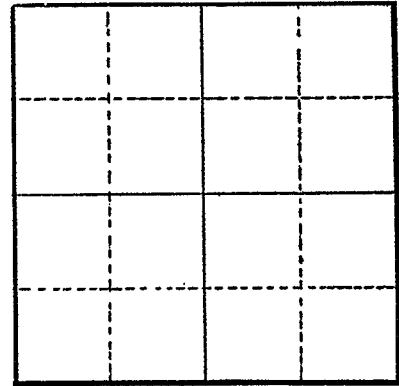

Section

Altitude at well

TYPE OF WELL: drilled Date Constructed 1946

Depth drilled 203' Depth cased

CASING RECORD:

6"

FINISH:

AQUIFERS:

WATER LEVEL:

70'

PUMPING EQUIPMENT: Type Peerless Turbine H.P. 10
Capacity 175 G.P.M.

WELL TESTS:

Drawdown ft. after hours G.P.M.
Drawdown ft. after hours G.P.M.

USE OF WATER Irrigation Temp. °F., 19

SOURCE OF INFORMATION GR-3103

DRILLER or DIGGER Miller of Aurora, Oregon

ADDITIONAL DATA:

Log Water Level Measurements Chemical Analysis Aquifer Test

REMARKS: