

STATE ENGINEER  
Salem, Oregon

MARI.....  
13270

# Well Record

STATE WELL NO. 8/LW-27A(1)  
COUNTY Marion  
APPLICATION NO. GR-2254

OWNER: Len R. Edwards


MAILING ADDRESS: Rt. 3 Box 845

LOCATION OF WELL: Owner's No. 1

CITY AND STATE: Salem, Oregon

NE 1/4 NE 1/4 Sec. 27 T. 8 S, R. 4 W., W.M.

Bearing and distance from section or subdivision corner 830' W. & 92' S. from NE cor. Sec. 27

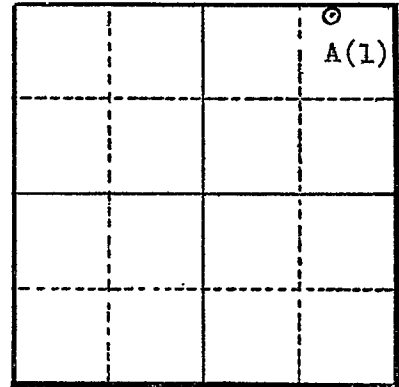

Section .....

Altitude at well .....

TYPE OF WELL: Drilled Date Constructed 1948

Depth drilled 18' Depth cased .....

CASING RECORD:  
10 inch

FINISH:  
Perforated casing

AQUIFERS:  
Sand & gravel from 9 to 18 feet

WATER LEVEL:  
4 feet below land surface

PUMPING EQUIPMENT: Type F. M. H.P. 15  
Capacity 300 G.P.M.

WELL TESTS:  
Drawdown 10+ ft. after ..... hours 600 G.P.M.  
Drawdown ..... ft. after ..... hours ..... G.P.M.

USE OF WATER Irrigation (25 acres) Temp. ..... °F. ...., 19

SOURCE OF INFORMATION GR-2151

DRILLER or DIGGER Fred Wymore

ADDITIONAL DATA:  
Log  Water Level Measurements ..... Chemical Analysis ..... Aquifer Test .....

REMARKS:  
Clay & sandy loam 0 to 9  
Sand & gravel 9 to 18